

Ellsworth


KANSAS

O.W.W.O.

Section.....34.....Township.....17.....Range.....8-W

Well Number.....4 - Rolfs.....

Company.....Continental et al.....

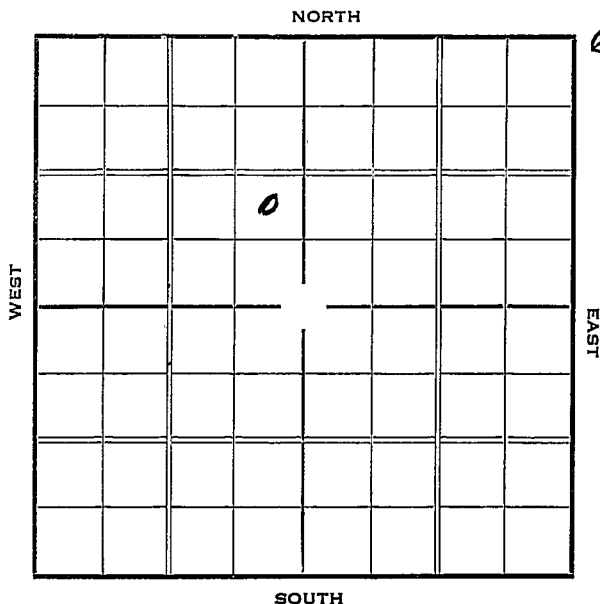

Sec. 34 Twp. 17 R. 8-W

Well No. #4 Rolfs Farm
Continental et al Company

 Ft. from N. Line


990 Ft. from S. Line

330 Ft. from E. Line

 Ft. from W. Line

NE SE NW

Elev. 1788

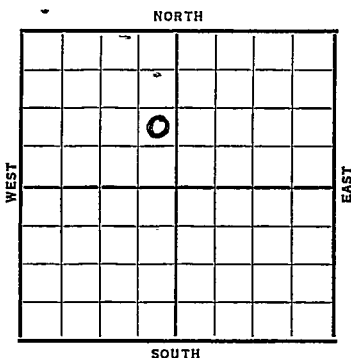

Date	REPORT
1937	
7/14	Cellar
7/23	Rig.
7/30	"
8/6	10" @ 186'. Drlg. 400'.
8/13	Dr lg. 2470'.
8/20	Sil. 3322'. 7" @ 3323'.
	T.D. 3324'. RUST;
8/28	" " " "
9/1	7" @ 3223'.
	Sil. 3222'.
	T.D. 3235'.
	4000 acid.
	Pump 243 bbls. 4 hrs. &
	236 bbls. 4 hrs.
	Potl 1418 bbls.
	COMPLETED
	OVER

1955
5/25

O.W.W.O.

Oil well TD 3235 OTD 3235
7" @ 3223 Simp 3193 Arb. 3222'
Lans. 2850 PB 3208 20/3193-98
B/5 GO 5 hr. frac. S/1/2 BOPH
9/3157-60 10/3185-89 10/3162-67
Comp. 3 BOPD

FIRST REPORT



COMPLETED

KANSAS

Ellsworth

Map No. _____ Sec. 34 Twp. 17 R. 8WWell No. 4. RolfsContinental etal Company

Contractor

FIRST REPORT

SECTION PLAT

	0		

_____ Ft. from N. Line

990 Ft. from S. Line330 Ft. from E. Line

_____ Ft. from W. Line

Location _____

Rig up _____

Drilling and Remarks:

cellar

RECORD

Cased _____ in., _____ ft.

Sand _____

Gas _____

Oil _____

Total Depth _____

PRODUCTION

1st 24 hrs. Nat. _____

1st 24 hrs. after shot _____

Gas _____ Cu. Ft.

Dry Hole _____

Abandoned _____

Date

JUL 14 1937H. D. Hatfield Scout

RAH

Returned _____

Cards _____

Tracing _____

France Map _____

Scarborough Map _____

Moody Map _____

Scarborough Plat Book _____

Moody Plat Book _____

KANSAS

Form 26—1M Bks.—2-29

Map No. 45 Sec. 34 Twp. 17 R. 8WWell No. 4-RollsContinental Company

Contractor

COMPLETED

SECTION PLAT

	0		

Ft. from N. Line

990 Ft. from S. Line330 Ft. from E. Line

Ft. from W. Line

Location

Rig up

Drilling and Remarks:

4000 Acid

RECORD

Cased 7 in. 3223 ft.Sand 51/3222

Gas

Oil

Total Depth 3235

PRODUCTION

1st 24 hrs. Nat.

1st 24 hrs. after shot

Gas 1000 Cu. Ft.

Dry Hole

Abandoned


Date

SEP 1 1937

19


H. D. Hatfield

Scout

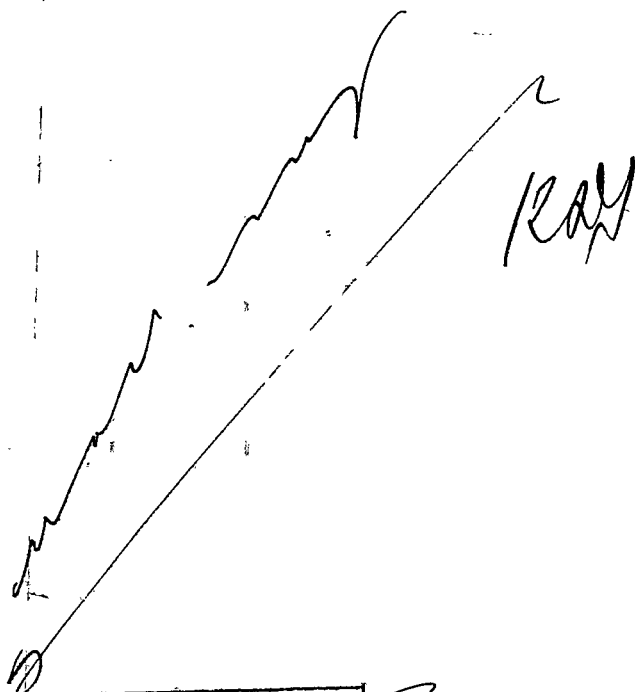

Returned	_____
Cards	_____
Tracing	_____
France Map	_____
Scarborough Map	_____
Moody Map	_____
Scarborough Plat Book	_____
Moody Plat Book	_____

O.W.W.O.

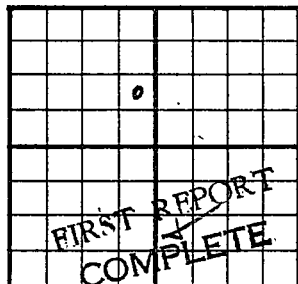County ~~Ellsworth~~ ~~Rice~~ State **Kansas**Sec. **34** (Blk. Twp.) **17** (Sur. Rge.) **8W** Map No.Operator **Continental Oil**Well No. **4** Farm **J. F. Rölfs**Elev. Location **NE SE NW**990 Ft. From **S** Line **NW**330 Ft. From **E** Line **Quarter**1st. Report **MAY 25 1955**

Completion

Remarks

O.W.W.O.

Spudding Date

Drig. Data **Oil well** **TD 3235****OTD 3235 7" @ 3223 Simp. 3193****Arb. 3222 Lans. 2850 PB 3208****20/ 3193-98 B/ 5 go 5 hr. frac****S/ 1/2 bo ph 9/ 3157-60 10/ 3185-89****10/ 3162-67 Comp. 3 bopd**

Scout Cards	
Land Small Map	
Land Wall Map	
Tracings	
France Map	
Picree Map	
Misc.	

MAY 31 1955

Orig. Date