

Sec. 34 Twp. 17 R. 8-W

Well No. #7 Rolfs Farm


Continental et al Company

330 Ft. from N. Line

_____ Ft. from S. Line

_____ Ft. from E. Line

1320 Ft. from W. Line

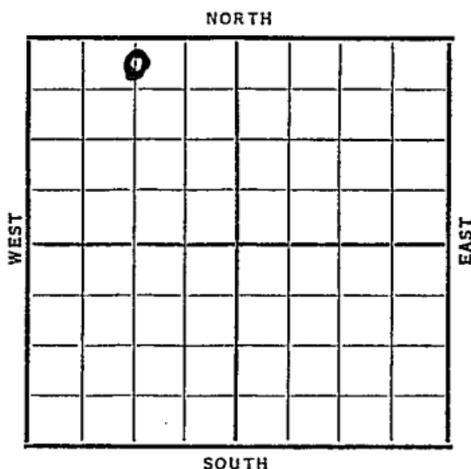

Elev. 1780

Date	REPORT
1938	
3/16	B.C.R.
3/25	10" @ 211'.
	WOC.
4/1	Drlg. 2980'.
4/8	Arb. 3239'. T.D. 3241' S.O.
	7" @ 3240'. RUST.
4/15	T.D. 3254'. 3150' oil.
4/20	7" @ 3240'.
	Arb. 3239'.
	T.D. 3254'.
	P000 acid.
	Potential 1926 bbls.
	COMPLETED

Map No. 45 Sec. 34 Twp. 17 R. 8W

Well No. 7 Rolfs

Continental etal Company

Contractor

FIRST REPORT

C N L NW

330 Ft. from N. Line

_____ Ft. from S. Line

_____ Ft. from E. Line

1320 Ft. from W. Line

SECTION PLAT

0			

Location _____

Rig up _____

Drilling and Remarks:

BCR

RECORD

Cased _____ in., _____ ft.

Sand _____

Gas _____

Oil _____

Total Depth _____

PRODUCTION

1st 24 hrs. Nat. _____

1st 24 hrs. after shot _____

Gas _____ Cu. Ft.

Dry Hole _____

Abandoned _____

Date

MAR 16 1938 19

H. D. Hatfield

Scout

Ellsworth **KANSAS**Map No. 45 Sec. 34 Twp. 17 R. 8WWell No. 7 RolfsContinental etal Company

Contractor

COMPLETED**SECTION PLAT**

C N L NW

530 Ft. from N. Line

_____ Ft. from S. Line

_____ Ft. from E. Line

1320 Ft. from W. Line

0			

Location _____

Rig up _____

Drilling and Remarks:

1000 acidLot 1926**RECORD**Cased 7 in., 3240 ft.Sand Arb 3239

Gas _____

Oil _____

Total Depth 3254**PRODUCTION**

1st 24 hrs. Nat. _____

1st 24 hrs. after shot _____

Gas _____ Cu. Ft.

Dry Hole _____

Abandoned _____

Date

APR 20 1938 19H. D. Hatfield Scout