


KANSAS

Section 34 Township 17 Range 9^W

Well Number 1 Elizabeth

Company Carter Oil

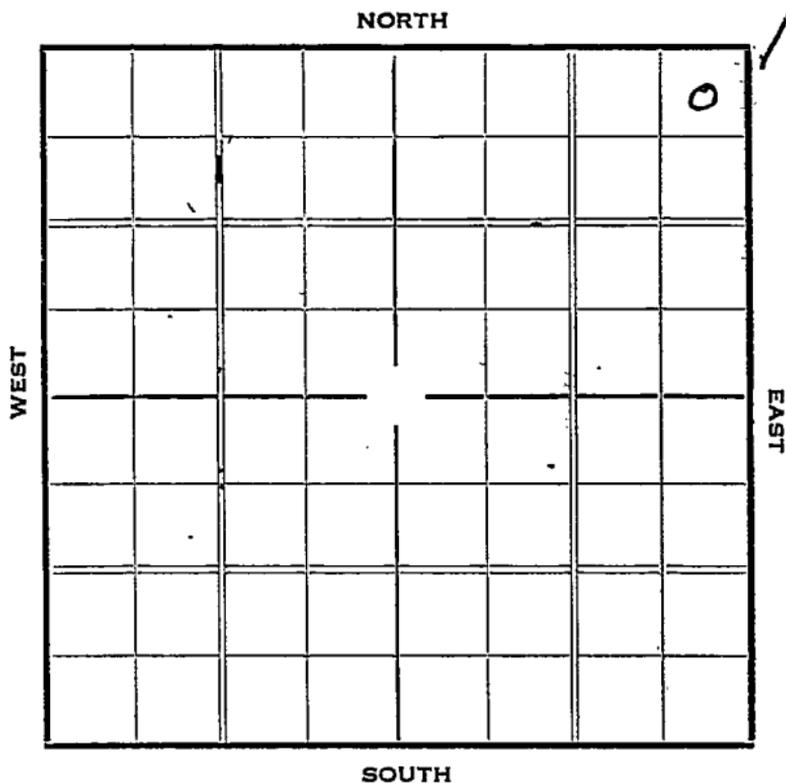

Sec. 34 Twp. 17 R. 9-W

Well No. #1 Elizabeth Farm
Carter Oil Company


330 Ft. from N. Line

_____ Ft. from S. Line

330 Ft. from E. Line

_____ Ft. from W. Line

Elev. 1765

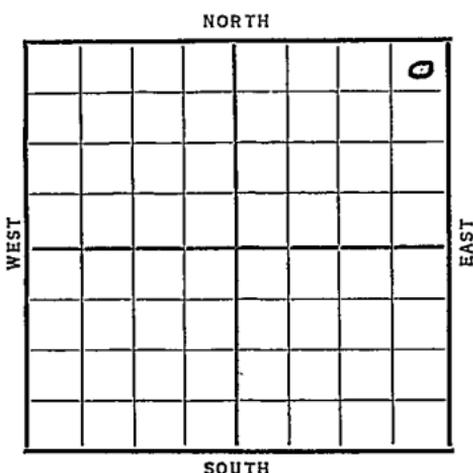

Date	REPORT
1936	
11/18	Location
11/19	
11/27	Rigging up
12/3	10" @ 205'. Drlg. 1480'.
12/10	Drlg. 2985'.
12/17	Sil. 3166'. 7" @ 3165'.
	T. D. 3169'. RUST.
12/24	T. D. 3173'. 400' oil in hole
12/29	36 shots 3166-69'. C. O.
1937	
1/7	T. D. 3186'.
1/14	1000 acid. Pump 50 bbls. per hour.
1/20	Sil. 3166'. T. D. 3186'.
	36 shots 3166-69'.
	1000 acid.
	Pot 1147 oil 31 water.
	COMPLETED

Map No. 47 Sec. 34 Twp. 17 R. 9W

Well No. 1 Elizabethe

Carters Oil Company

Contractor

SECTION PLAT

			0

330 Ft. from N. Line

_____ Ft. from S. Line

330 Ft. from E. Line

_____ Ft. from W. Line

FIRST REPORT

Location ✓

Rig up _____

Drilling and Remarks:

RECORD

Cased _____ in., _____ ft.

Sand _____

Gas _____

Oil _____

Total Depth _____

PRODUCTION

1st 24 hrs. Nat. _____

1st 24 hrs. after shot _____

Gas _____ Cu. Ft.

Dry Hole _____

Abandoned _____

Date

NOV 18 1936

Map No. 43 Sec. 34 Twp. 17 R. 9W

Well No. 1 Elizabeth

Carters Company

Contractor

SECTION PLAT

			0

330 Ft. from N. Line

_____ Ft. from S. Line

330 Ft. from E. Line

_____ Ft. from W. Line

COMPLETED

Location _____

Rig up _____

Drilling and Remarks:

S. 3166
3.6 shots
3166-69
1000 acid
Prod 1147 oil
31 water

RECORD

Cased _____ in., _____ ft.

Sand _____

Gas _____

Oil _____

Total Depth 3186

PRODUCTION

1st 24 hrs. Nat. _____

1st 24 hrs. after shot _____

Gas _____ Cu. Ft.

Dry Hole _____

Abandoned _____

Date

JAN 20 1937 19

S. J. LEWIS

Scout