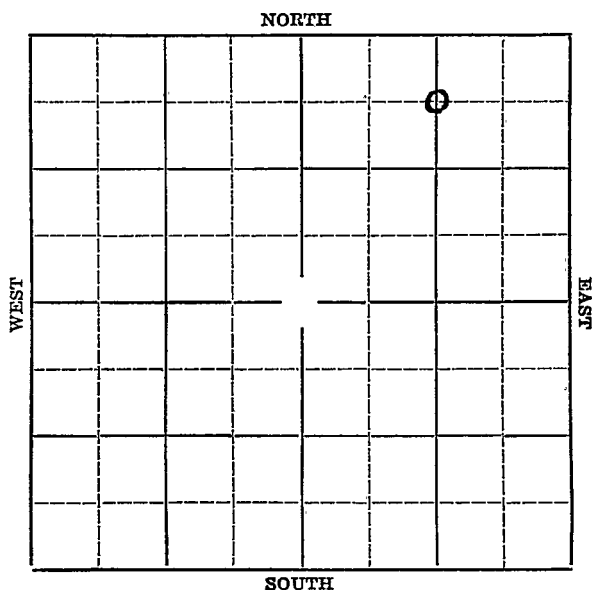


Section 34 Township 17 Range 9-WWell Number 3 ElizabethCompany Carter et al

Well No. #3 Elizabeth Farm


Carter et al _____ Company

660 Ft. from N. Line

Ft. from S. Line

1320 Ft. from E. Line

Ft. from W. Line

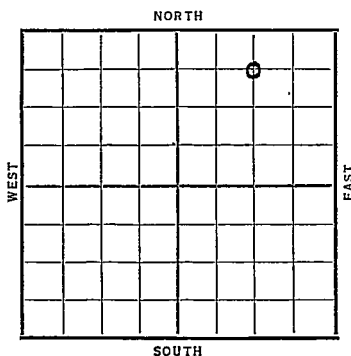[illegible]

KANSAS

Map No. 45 Sec. 34 Twp. 17 R. 9WWell No. 3 ElizabethCarter & Co Company

Contractor

SECTION PLAT

			0

660 Ft. from N. Line1320 Ft. from S. Line1320 Ft. from E. Line

_____ Ft. from W. Line

FIRST REPORT

Location _____

Rig up _____

Drilling and Remarks:

10' @ 206July 1160

RECORD

Cased _____ in., _____ ft.

Sand _____

Gas _____

Oil _____

Total Depth _____

PRODUCTION

1st 24 hrs. Nat. _____

1st 24 hrs. after shot _____

Gas _____ Cu. Ft.

Dry Hole _____

Abandoned _____

Date

FEB 24 1937 19

S. I. LEWIS Scout

KANSAS EllsworthMap No. _____ Sec. 34 Twp. 17 R. 9W.Well No. 3 ElizabethCarter Company_____
Contractor**SECTION PLAT**

			0

660 Ft. from N. Line

_____ Ft. from S. Line

1320 Ft. from E. Line

_____ Ft. from W. Line

ABANDONED

Location _____

Rig up _____

Drilling and Remarks:

Sil 3180HFH 3194**RECORD**

Cased _____ in., _____ ft.

Sand _____

Gas _____

Oil _____

Total Depth 3200**PRODUCTION**

1st 24 hrs. Nat. _____

1st 24 hrs. after shot _____

Gas _____ Cu. Ft.

Dry Hole ☒Abandoned ☒

Date

APR 7 1937

19

S. J. LEWIS

Scout