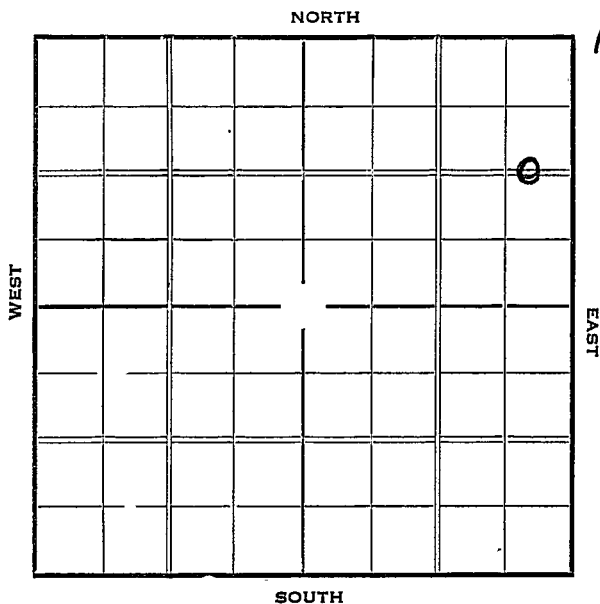


Ellsworth

KANSAS

Section 34 Township 17 Range 9-WWell Number 2 ElizabethCompany Carter

KANSAS

Ellsworth

Map No. _____ Sec. 34 Twp. 17 R. 9-WWell No. #2 Elizabeth Farm _____


_____ Carter _____ Company

1320 Ft. from N. Line

_____ Ft. from S. Line

440 Ft. from E. Line

_____ Ft. from W. Line

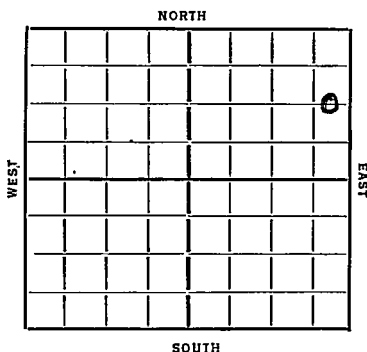Date
1936

REPORT

12/22 Location12/29 Building rig.19371/7 10" @ 207'. Drlg. 525'.1/14 Drlg. 2485'.1/21 Sil. 3171'. Run 7".1/28 Drlg. 3178'. 2000' oil in hole.2/3 Sil. 3171'.

T. D. 3178'.

Potential 1020 .

COMPLETED

Form 28-1 MPBRS 2-25
KANSAS

Map No. 45 Sec. 34 Twp. 17 R. 9W

Well No. 2 Elizabeth

Carter Company

Contractor

SECTION PLAT

			0

1320 Ft. from N. Line

_____ Ft. from S. Line

440 Ft. from E. Line

_____ Ft. from W. Line

FIRST REPORT

Location ✓

Rig up _____

Drilling and Remarks:

RECORD

Cased _____ in., _____ ft.

Sand _____

Gas _____

Oil _____

Total Depth _____

PRODUCTION

1st 24 hrs. Nat. _____

1st 24 hrs. after shot _____

Gas _____ Cu. Ft.

Dry Hole _____

Abandoned _____

Date

DEC 22 1936 19

S. J. LEWIS Scout

KANSAS

Map No. 45 Sec. 34 Twp. 17 R. 9WWell No. 2 ElizabethCarter Oil Company

Contractor

SECTION PLAT

			0

1320 Ft. from N. Line

_____ Ft. from S. Line

440 Ft. from E. Line

_____ Ft. from W. Line

COMPLETED

RECORD

Location _____

Cased _____ in., _____ ft.

Rig up _____

Sand _____

Drilling and Remarks:

Gas _____

Oil _____

Total Depth 3128

PRODUCTION

1st 24 hrs. Nat. _____

1st 24 hrs. after shot _____

Gas _____ Cu. Ft.

Dry Hole _____

Abandoned _____

Date

FEB 3 1937

19

S. J. LEWIS Scout