


KANSAS

FORM 51 5M BR1X

Section 34 Township 17 Range 5W

Well No. #1 W. L. Kingsley

Company El dorado Ref.

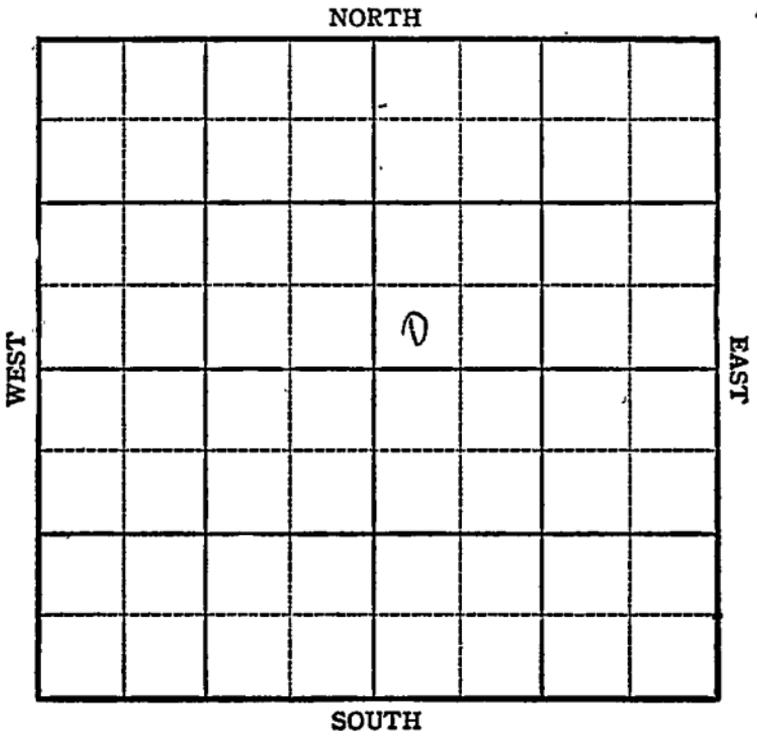

KANSAS

Sec. 34 Twp. 17 R. 5W

Well No. #1 W. L. Kingsley Farm

Eldorado Ref. Company


Wildcat

_____ Ft. from N. Line

330 _____ Ft. from S. Line

_____ Ft. from E. Line

330 _____ Ft. from W. Line

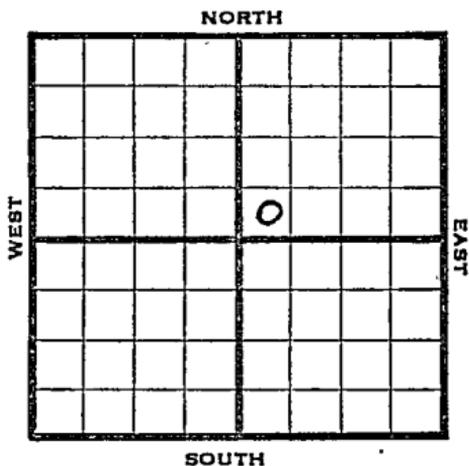

McPherson SW NE

1944 *Elev. 1407* R E P O R T

- 11/29 Loc.
- 12/6 Drlg. 2520
- 12/14 Miss: 3211
Drlg. 3411'
- 12/20 Viola 3630
TD 3681'

ABANDONED

Pool Name W. P. C. T.

Map No. 44 Sec. 34 Twp. 17 R. 5W

Well No. 1 W. L. Kingstey

Eldorado Ref. Company

FIRST REPORT Contractor

SW NE


SECTION PLAT

_____ Ft. from N. Line

330 Ft. from S. Line

_____ Ft. from E. Line

330 Ft. from W. Line

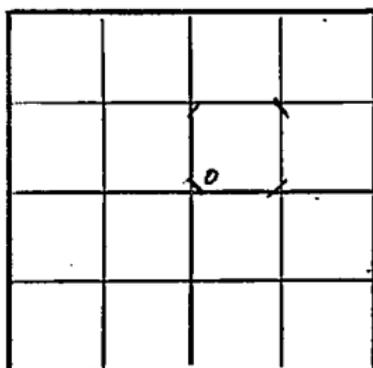

McPherson

Location X

Rig up _____

Drilling and Remarks:

RECORD

Cased _____ in., _____ ft.

Sand _____

Gas _____

Oil _____

Total Depth _____

PRODUCTION

1st 24 hrs. Nat. _____

1st 24 hrs. after shot _____

Gas _____ Cu. Ft.

Dry Hole _____

Abandoned _____

Date

NOV 29 1944 19

S. J. LEWIS Scout

Pool Name WildcatMap No. 44 Sec. 34 Twp. 17 R. 5WWell No. 1 W.L. Kingsley

Eldorado Ref. _____ Company

ABANDONED

Contractor _____

SW NE

SECTION PLAT

		o	

_____ Ft. from N. Line

330 Ft. from S. Line

_____ Ft. from E. Line

330 Ft. from W. LineMcPherson

Location _____

Rig up _____

Drilling and Remarks:

Vista 3680

RECORD

Cased _____ in., _____ ft.

Sand _____

Gas _____

Oil _____

Total Depth 3681

PRODUCTION

1st 24 hrs. Nat. _____

1st 24 hrs. after shot _____

Gas _____ Cu. Ft.

Dry Hole _____

Abandoned _____

Date

DEC 20 1944 19S. J. LEWIS

Scout