


Section 34 Township 17 Range 1-W

Well No. #1 Clark

Company Elbar Oil

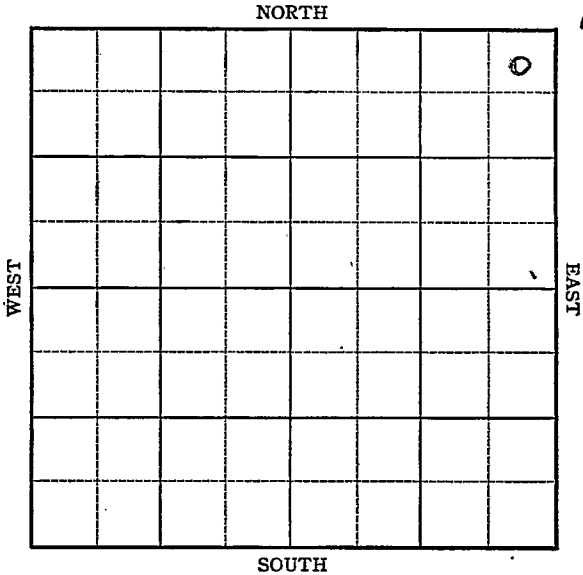

Sec. 34 Twp. 17 R. 1W

Well No. #1 Clark Farm

Elbar Oil Company

Crowther


330 Ft. from N. Line

_____ Ft. from S. Line

330 Ft. from E. Line

_____ Ft. from W. Line

NE/c

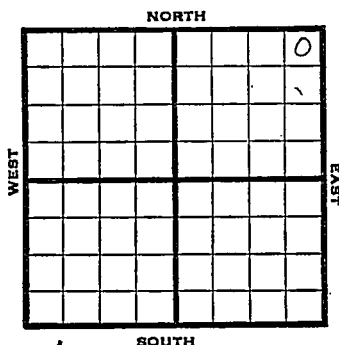

1946

Elev. 1400

REPORT

1/23

Location

1/31

8" - 158' Drlg. 702'

2/7

Drlg. 2022'

2/14

Miss 2726' 5" - 2740'

T.D. 2745' 950' oil & 500' water, in 16 hours.

2/21

500 acid. Pump 120 oil & 40 wtr in 12 hours.

2/28

"

3/6

Miss. 2726

5" @ 2740

500 acid.

TD 2745'

Pump 176 Pot.

Grav. 36.0

COMPLETED

KANSAS Kansas Pool Name CrowtherMap No. 42 Sec. 34 Twp. 17 R. 1WWell No. 1 Clark

Elbar Oil _____ Company

FIRST REPORT _____ Contractor

NE/c

330 _____ Ft. from N. Line

_____ Ft. from S. Line

330 _____ Ft. from E. Line

_____ Ft. from W. Line

McPherson County

Location X _____

Rig up _____

Drilling and Remarks:

RECORD

Cased _____ in., _____ ft.

Sand _____

Gas _____

Oil _____

Total Depth _____

PRODUCTION

1st 24 hrs. Nat. _____

1st 24 hrs. after shot _____

Gas _____ Cu. Ft.

Dry Hole _____

Abandoned _____

Date

JAN 23 1946 19 _____S. J. LEWIS Scout

KANSAS Kansas Pool Name Crowther
 Map No. 42 Sec. 34 Twp. 17 R. 1W
 Well No. 1 Clark

Elbar Oil Company

COMPLETED Contractor
NE/c EL 1400

SECTION PLAT

330 Ft. from N. Line
 _____ Ft. from S. Line
330 Ft. from E. Line
 _____ Ft. from W. Line

			0

McPherson County

Location _____

Rig up _____

Drilling and Remarks:

Miss 2726
5" 62740
5000000
Pump 176 Pst

36 0/8

RECORD

Cased _____ in., _____ ft.

Sand _____

Gas _____

Oil _____

Total Depth 2745

PRODUCTION

1st 24 hrs. Nat. _____

1st 24 hrs. after shot _____

Gas _____ Cu. Ft.

Dry Hole _____

Abandoned _____

Date

MAR 6 1946 19

S. J. LEWIS Scout