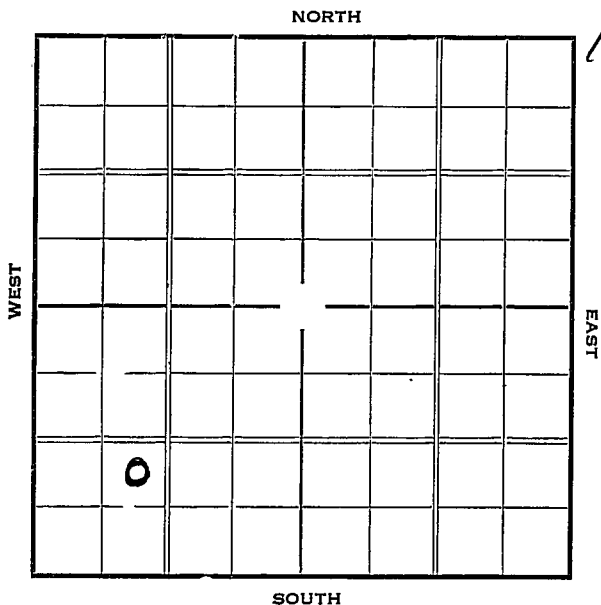


Section 34 Township 17 Range 8-WWell Number 9 Jansen "B"Company Continental et al

KANSAS

Ellsworth

Map No. 45 Sec. 34 Twp. 17 R. 8^WWell No. 9-Jansen "B"Continental etal Company

Contractor

COMPLETED

SECTION PLAT

0			

_____ Ft. from N. Line

990 Ft. from S. Line

_____ Ft. from E. Line

990 Ft. from W. Line

Location _____

Rig up _____

Drilling and Remarks:

4000 APat- 312

RECORD

Cased 7 in., 3226 ft.Sand 511 3225Gas Pay 3240-50

Oil _____

Total Depth 3253

PRODUCTION

1st 24 hrs. Nat. _____

1st 24 hrs. after shot _____

Gas _____ Cu. Ft.

Dry Hole _____

Abandoned _____

Date

JUN 9 1937 19

H. D. Hatfield

Scout

KANSAS Ellsworth

Map No. _____ Sec. 34 Twp. 17 R. 8WWell No. 9 Jansen "B"Continental & Nat Company

Contractor _____

SECTION PLAT

0			

_____ Ft. from N. Line

990 Ft. from S. Line

_____ Ft. from E. Line

990 Ft. from W. Line

FIRST REPORT

Location ✓

Rig up _____

Drilling and Remarks:

RECORD

Cased _____ in., _____ ft.

Sand _____

Gas _____

Oil _____

Total Depth _____

PRODUCTION

1st 24 hrs. Nat. _____

1st 24 hrs. after shot _____

Gas _____ Cu₂ Ft.

Dry Hole _____

Abandoned _____

Date

APR 21 1937 19

S. J. LEWIS Scout