


Ellsworth

KANSAS

SECTION 35 TOWNSHIP 17S RANGE 8W

WELL NO. #1 Gray

COMPANY Lee Phillips Oil Co.

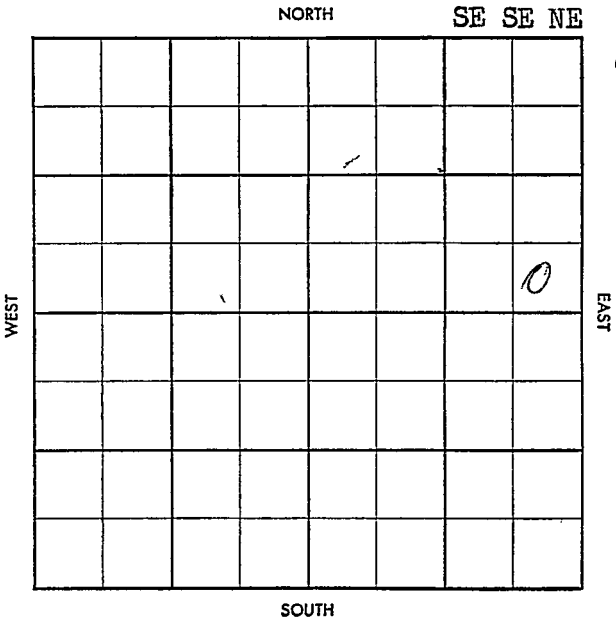


~~Top~~ ~~Pool~~
~~Co.~~ ~~Facet~~

513-B

County Ellsworth Elev. _____
 Sec. 35 Twp. 17 Rge. SW
 Company Lee Phillips Oil Co.
 Farm Name Gray No. 1

TOPS	DEPTH	LOG	DATUM
Anh.			
Tp.			
H.			
Tr.			
Dg.			
B.L.			
L.			
K.C.			
B.K.C.			
Ce.			
C.			
M.			
M.			
K.			
Mz.			
Mq.			
V.			
S.			
S.			
A.			
R.			
Pf.			
G.			
T.D.			

Loc. in Sec. _____
SE SE NE
 Geol. _____
 Contr. _____
Harms & Burt
#2
 Pool _____
Edwards

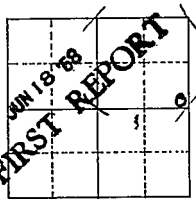

Date Comm. 6-14-68
8" @ 364 Drlg. 1490.

Co.
 Lse.
 No.
 Sec.
 T.
 R.

~~Twp.~~ ~~Pool~~
~~Co.~~ ~~Section~~

S-513-B

County Ellsworth Elev. 1763 OF 1766 RB
 Sec. 35 Twp. 17 Rge. 8W
 Company Lee Phillips Oil Co.
 Farm Name Gray No. 1

TOPS	DEPTH	LOG	DATUM
Anh.			
Tp.			
H.	<u>2692</u>		
Tr.			
Dg.			
B.L.	<u>2816</u>		
L.	<u>2842</u>		
K.C.			
B.K.C.	<u>3170</u>		
Ce.			
C.	<u>3233</u>		
M.			
M.			
K.			
Mz.			
Mq.			
V.			
S.			
S.			
A.			
R.			
Pf.			
G.			
T.D.	<u>3263</u>		

Loc. in Sec. SE SE NE
 Geol. _____
 Contr. Harms & Burt #2
 Pool Edwards
ABANDONED
 JUN 25 '58

Date Comm. 6-14-58
8" x 364 Drlg. 1490. JUN 25 '58 no log

DoA

Co.
Lse.
No.
Sec.
T.
R.