


Section 35 Township 17 Range 8W

Well No. #1 Gray

Company E. K. Carey

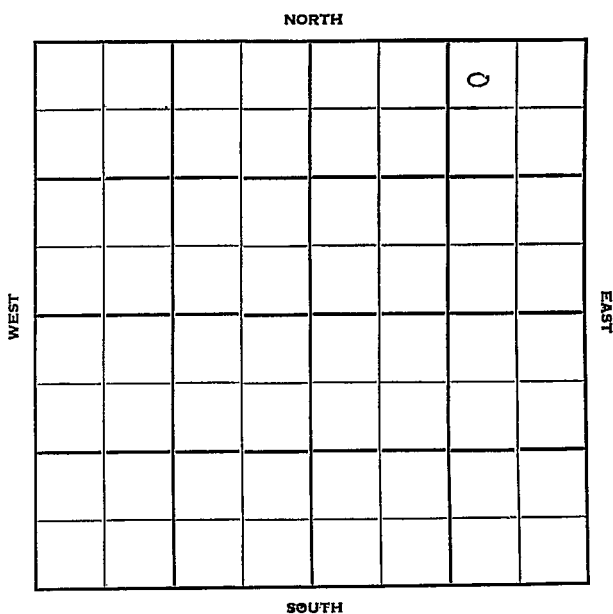

Sec. 35 Twp. 17 R. 8W

Well No. #1 Gray Farm

E. K. Carey Company


Carey Contractor  
Maes

330 Ft. from N. Line

Ft. from S. Line

990 Ft. from E. Line

Ft. from W. Line

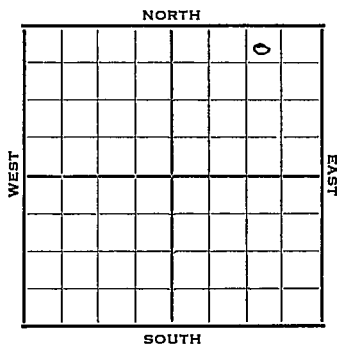

NW NE NE

1952

Elev. 1741'

REPORT

6/18

Spud 6-6-52  
8" @ 300'  
Heeb. 2654 Br Li 2776  
Lans. 2800  
DST 2888-97, 1/2 hr. 130' HO&GCM  
1000#  
V. 3216 Simp. 3260  
Arb. 3316 ? Circu.

6/25

RTD 3322' 5" @ 3320' CO 3322'  
S/7 1/2 BOPH nat. DD

7/2 DD 3336 TD S/22 BOPH 500' off  
btm tub & rods

7/9 NR

7/16

Spud 6-6-52  
Oil well TD 3336' 8" @ 300  
Heeb 2654' Br. lime 2776' Lans. 2800'  
DST 2888-97 open 1/2 hr. rec 130' HO &  
GCM. 1000# Viola 3216' Simp. 3260'  
Arb. 3316' TD 3322' 5" @ 3320'  
CO to 3322' S/7 1/2 BOPH DD 3336'  
S/22 BOPH  
Comp. 590 BOPD 10% water.

COMPLETED

County Ellsworth State Kansas

Sec. 35 (Blk. Twp.) 17 (Sur. Rge.) 8W Map No.

Operator E. K. Carey

Well No. 1 Farm Gray

Elev. 1741 Location NW NE NE


530 Ft. From N Line NE

990 Ft. From E Line Quarter

1st. Report JUN 18 1952

Completion \_\_\_\_\_

Remarks \_\_\_\_\_

Carey - Contr.

Spudding Date 6-6-52

Drlg. Data Haas

8" @ 300 Heeb 2654 BrL 2776 Lans 2800

DST 2888-97 1/2 hr. 130° Ho & gem 1000#

V-3216 Simp 3260 Arb 3316 ? Circu

County Ellsworth State Kansas  
 Sec. 35 (Blk. 17 (Sur. 8W Map No.     )  
 (Twp.) (Rge.)  
 Operator E. K. Carey  
 Well No. 1 Farm Gray  
 Elev. 1741 Location NW NE NE


330 Ft. From N Line NE

990 Ft. From E Line Quarter

1st. Report

Completion JUL 16 1952Remarks Maes PoolCarey - Contr.Spudding Date 6-6-52Drlg. Data Oil well TD 33368" @ 300 Heeb. 2654 Br. line 2776Lans. 2800 DST 2888-97 open  $\frac{1}{2}$  hr.Rec. 130' ho & gcm 1000# Viola 3216Simp. 3260 Arb. 3316 TD 33225" @ 3320 CO to 3322 S/  $7\frac{1}{2}$  bophDD 3336 S/ 22 boph Comp. 590 bopd 10%

J. G. McGEHEE