


Section 35 Township 17 Range 8W

Well No. #1 Kratzer

Company Westgate-Greenland

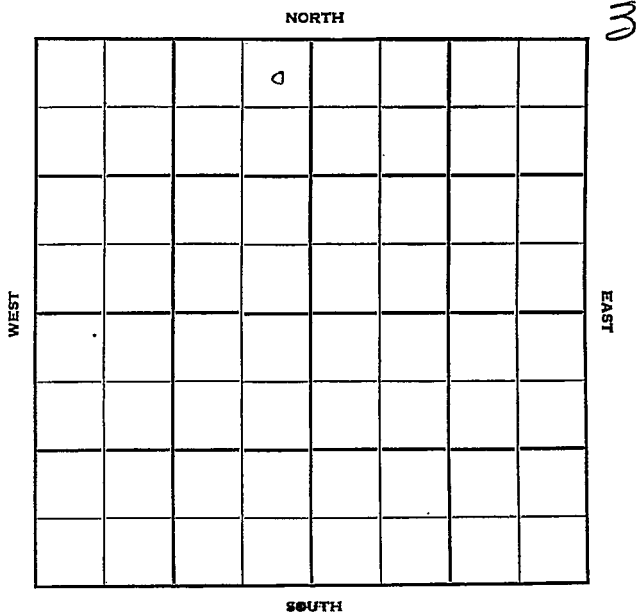

Sec. 35 Twp. 17 R. 8W

Well No. #1 Kratzer Farm

Westgate-Greenland Company

Jackson Drlg. - Contr. Contractor


330' Ft. from N. Line

_____ Ft. from S. Line

330' Ft. from E. Line

_____ Ft. from W. Line

NE NE NW

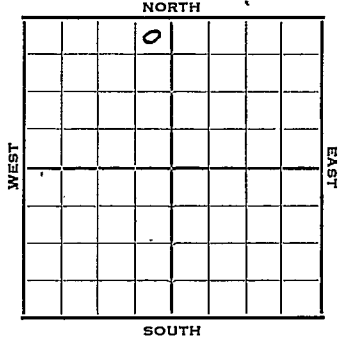

1952 Elev. 1759' REPORT

3/19

Spud 3-14-52
8" @ 214
Anhy 1100-1175
Drlg. 1543'

3/26

Spud 3-14-52
D&A TD 3466 8" @ 214
Anhy 1100-1175 Heeb. '2690
Br Li 2811 Lans. 2840
B KC 3169 Viola 3253
Simp. 3297 Arb. 3418-66 TD
D&A

ABANDONED

County **Ellsworth** State **Kansas**

Sec. **35** (Blk. Twp.) **17** (Sur. Rge.) **8W** Map No.

Operator **Westgate-Greenland**

Well No. **1** Farm **Kratzer**

Elev. Location **NE NE NW**

		0			

330 Ft. From **N** Line **NW**

330 Ft. From **E** Line Quarter

1st. Report **MAR 19 1952**

Completion

Remarks

Jackson Drlg. - Contr.

Spudding Date **3-14-52**

Drlg. Data

8" @ 214 Any 1100-1175 drlg. 1543

J. G. McGEHEE

County Ellsworth State Kansas

Sec. 35 (Blk. 17) (Sur. 8W) Map No.

Operator Westgate-Greenland

Well No. 1 Farm Kratzer

Elev. 1759 Location NE NE NW

		0			

330 Ft. From N Line NW

330 Ft. From E Line Quarter

Ist. Report

Completion MAR 26 1952

Remarks

Jackson Drlg. - Contr.

Spudding Date 3-14-52

Drlg. Data D & A TD 3466

8" @ 214 Anhy 1100-1175 Heeb. 2690

Br. lime 2811 Lans. 2840 B KC 3169

Viola 3253 Simp. 3297 Arb. 3418-66 TD

D & A