


KANSAS

Section 35 Township 17 Range 9-W

Well Number 3 Wollhagen

Company Carter Oil

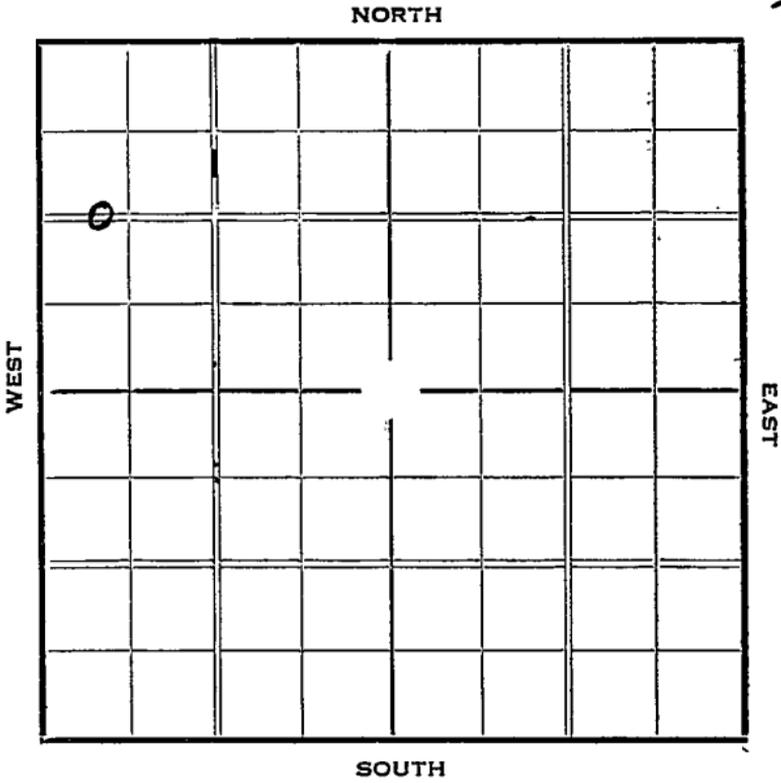

Sec. 35 Twp. 17 R. 9-W

Well No. #3 Wollhagen Farm
Carter Oil Company


1320 Ft. from N. Line

_____ Ft. from S. Line

_____ Ft. from E. Line

440 Ft. from W. Line

Elev. 1760

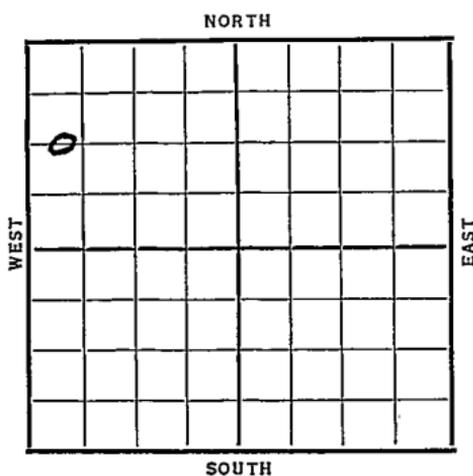

Date
1936

REPORT

11/18	Location
11/27	10" @ 203'. WOC
12/3	Drlg. 1992'.
12/10	Drlg. 2055'.
12/17	7" @ 3178'. Sil. 3180'.
	T. D. 3183'. 400' oil in hole.
12/29	Sil. 3180'. T. D. 3183'.
	1000 acid.
	Pot 1257.

COMPLETED



Carter Oil Company

Contractor

SECTION PLAT

0			

1320 Ft. from N. Line

_____ Ft. from S. Line

_____ Ft. from E. Line

440 Ft. from W. Line

FIRST REPORT

Location

Rig up _____

Drilling and Remarks:

RECORD

Cased _____ in., _____ ft.

Sand _____

Gas _____

Oil _____

Total Depth _____

PRODUCTION

1st 24 hrs. Nat. _____

1st 24 hrs. after shot _____

Gas _____ Cu. Ft.

Dry Hole _____

Abandoned _____

Date

NOV 18 1936 19

S. J. LEWIS Scout

Map No. 45 Sec. 35 Twp. 17 R. 9W


Carter Company

Contractor

SECTION PLAT

1320 Ft. from N. Line

_____ Ft. from S. Line

_____ Ft. from E. Line

440 Ft. from W. Line

0			

COMPLETED

Location _____

Rig up _____

Drilling and Remarks:

Si 13150

1000 acd

P 81257

RECORD

Cased _____ in., _____ ft.

Sand _____

Gas _____

Oil _____

Total Depth 3183

PRODUCTION

1st 24 hrs. Nat. _____

1st 24 hrs. after shot _____

Gas _____ Cu. Ft.

Dry Hole _____

Abandoned _____

Date

DEC 29 1936 19

S. J. LEWIS Scout