


SECTION 35 TOWNSHIP 17 RANGE 9 W

WELL NO. #1 Mollhagen

COMPANY Bennett & Roberts

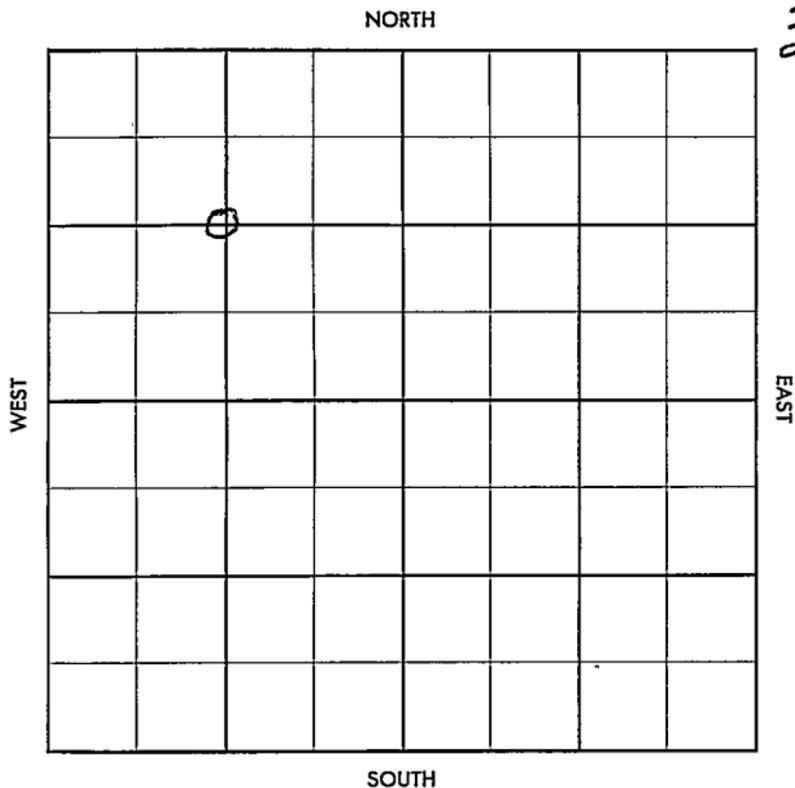

Ellsworth

KANSAS

SEC. 35	TWP. - 17	R. 9W
------------	--------------	----------

WELL NO.

#1 Mollhagen

FARM

COMPANY

Bennett & Roberts

CONTRACTOR

Co. Tools

Lorraine


_____ Ft. from N. Line

_____ Ft. from S. Line

_____ Ft. from E. Line

_____ Ft. from W. Line

C NW/4

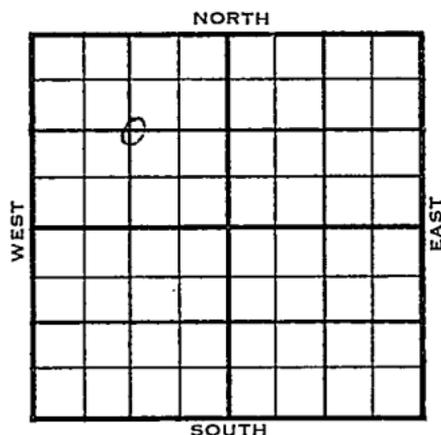

1955

ELEVATION

1764'

REPORT

12-7

Comm. 12-1-55
 8" @ 184/125
 Drlg. 2354
 Anh. 845'

1956

1-11

DST 3180-86 op 1 hr. rec. 300' muddy
 oil, 240' free oil, 60' wtr. 1020#
 5½" @ 3180/100
 GO to 3186,
 Comp. 28 bopd, 210 BW,
 Dodge 2731
 Doug. 2743
 K.C. 2840
 C. 3172
 Dolo 3180
 TD 3186'

COMPLETED

County Ellsworth Elev. _____
 Sec. 35 Twp. 17 Rge. 9W
 Company Bennett & Roberts
 FarmName Mollhagen No. 1

TOPS	DEPTH	LOG	DATUM
Anh.	<u>045</u>		
Tr.			
H.			
Tr.			
Dg.			
BL.			
L.			
K.C.			
B.K.C.			
Ce.			
C.			
M.			
M.			
K.			
Mz.			
Me.			
V.			
S.			
S.			
A.			
R.			
Pe.			
G.			
T.D.			

Loc. in Sec. G NW/4
 Geol. _____
 Contr. _____
Co. tools
 Pool Lorraine



Date Comm. 12-1-55
8" @ 184/125 drlg. 2354

Co.
 Lse.
 No.
 Sec.
 T.
 R.

[Handwritten signature]

County Ellsworth Elev. 1764
 Sec. 35 Twp. (17) Rge. 9W
 Company Bennett & Roberts
 Farm Name Mollhagen No. 1

TOPS	DEPTH	LOG	DATUM	Loc. in Sec.
Anh.	845			C NW/4
Tp.				
H.				
Tr.				
Dg. <u>Dodge</u>	2731		967	
Bl. <u>Dodge</u>	2743		979	
L.				
K.C.	2840		1076	Geol.
B.K.C.				Contr.
Ce.				
C.	3172		1408	Co. tools
M.				
M.				Pool
K.				Lorraine
Mz.				
Ma.				
V.				
S.				
S.				
A. <u>Dalo</u>	3180		1416	
R.				
PE.				
G.				
T.D.	3186			

Date Comm. 12-1-55 JAN 1 1 1956
8" @ 184/125 DST 3180-86 open 1 hr.
rec. 300' muddy oil 240' free oil
60' wtr. 1020# 5 1/2" @ 3180/100
CO to 3186 Comp. 28 bopd 210 bw

Co.
 No.
 Sec.
 T.
 R.