

KANSAS

FORM 51 5M 10-41 PETROL

McPherson

Section 35 Township 17 Range 2-W


Well No. #1 Johnson

Company Derby & Carey

Wildcat

NORTH

15

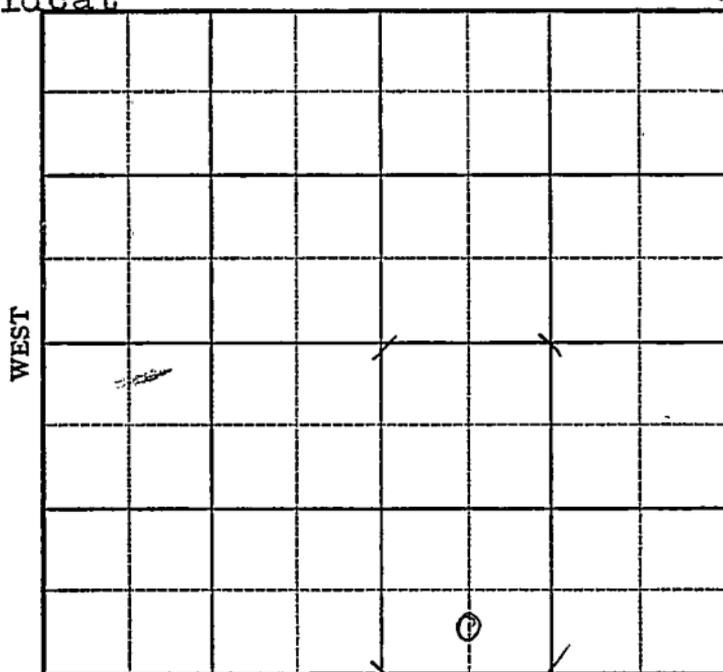

SOUTH

Sec. 35 Twp. 17 R. 2-W

Well No. #1 Johnson Farm

Derby & Carey Company

(Wildcat)


_____ Ft. from N. Line

330 Ft. from S. Line

_____ Ft. from E. Line

660 Ft. from W. Line

Elev. 1395'

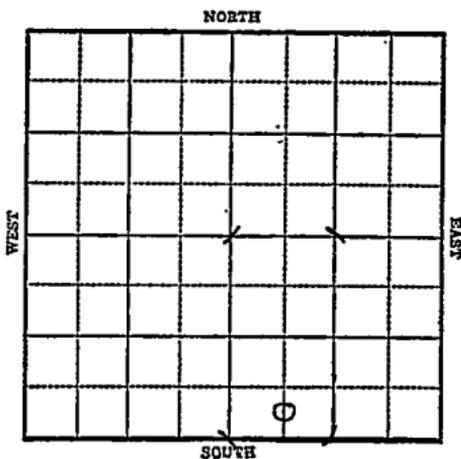

1942

R E P O R T

10/7 Derrick

10/14 Surface hole.

~~10/21~~ 10" @ 88' Lans 2132 Drlg 2190

10/28 Miss 2825
Drlg. 2979

11/11 Hunton 3135

Viola 3266

Arb. 3392

T.D. 3416'


No shows

ABANDONED

Map No. 42 Sec. 35 Twp. 17 R. 2WWell No. 1 JohnsonDerby & Carey Company**FIRST REPORT**

Contractor

C SL SW SE

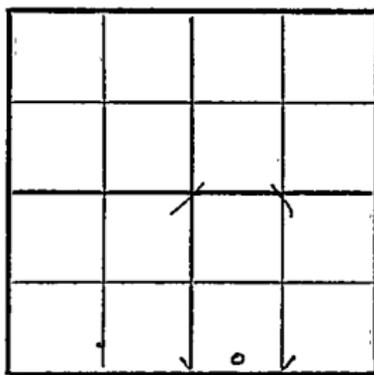SECTION PLAT Ft. from N. Line330 Ft. from S. Line Ft. from E. Line660 Ft. from W. Line**WILDCAT**Location Rig up

Drilling and Remarks:

Derrick**RECORD**Cased in., ft.Sand Gas Oil Total Depth **PRODUCTION**1st 24 hrs. Nat. 1st 24 hrs. after shot Gas Cu. Ft.Dry Hole Abandoned

Date

OCT 7 1942 19S. J. LEWIS Scout

