


McPhaerson

FORM 51 5M 1-42 PETROL

Section 36 Township 17 Range 4-W

Well No. #1 Bean Estate "B"

Company Globe Oil & Refining etal.

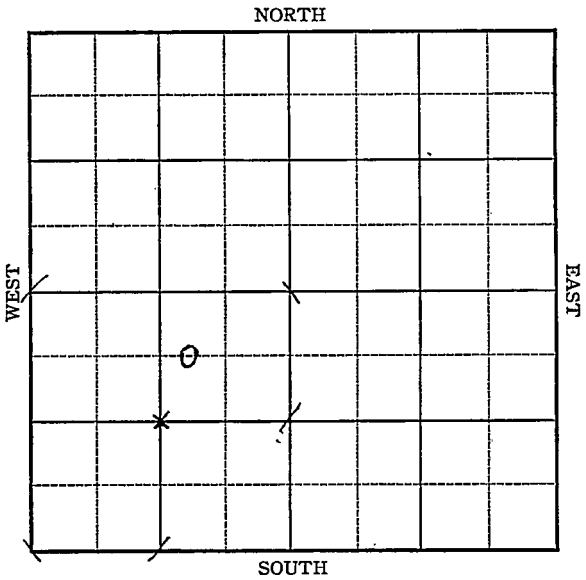

KANSAS

McPherson

Sec. 36 Twp. 17 R. 4-W

Well No. #1 Bean Estate "B" Farm

Globe Oil & Refining etal Company

Lindsborg Pool


660 Ft. from N. Line

 Ft. from S. Line

990 Ft. from E. Line

 Ft. from W. Line

Elev. 1352

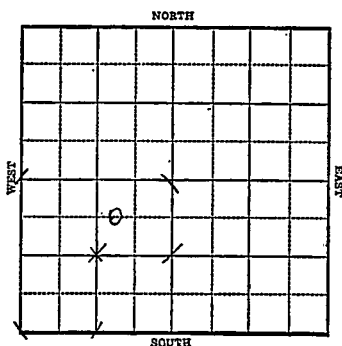

1943

R E P O R T

3/10 Location

3/16 Rotary.

3/24 "

3/31 12" @ 181 Drlg. 385

4/7 Drlg. 2720'

4/14 Miss 2939
B. Miss 3178
Drlg. 3404'

4/21 Viola 3407
T.D. 3547
5" @ 3510 RUST.


4/28 Simp. 3522
5" @ 3510'
Viola 3407
T.D. 3547'
84 shots 3405-19
Pump 173 Pot.
Gravity 36.4

COMPLETED

KANSASMap No. 44 Sec. 36 Twp. 17 R. 4WWell No. 1 Bean Estate "B"Globe Oil & Refining etal.
Company**FIRST REPORT**

Contractor

C WL NE SW

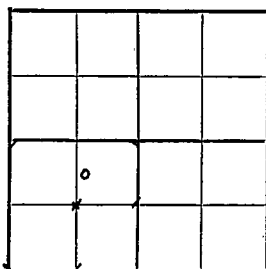SECTION PLAT660 Ft. from N. Line Ft. from S. Line990 Ft. from E. Line Ft. from W. Line**LINDSBORG POOL**Location XXXXRig up

Drilling and Remarks:

RECORDCased in., ft.Sand Gas Oil Total Depth **PRODUCTION**1st 24 hrs. Nat. 1st 24 hrs. after shot Gas Cu. Ft.Dry Hole Abandoned

Date

MAR 10 1943 19S. J. LEWIS Scout

McPherson

KANSAS

Map No. 94 Sec. 36 Twp. 17 R. 4WWell No. 1 Bean Estate "B"Globe Oil & Refining Company**COMPLETED**

Contractor

C WL NE SW


SECTION PLAT

660 Ft. from N. Line

Ft. from S. Line

990 Ft. from E. Line

Ft. from W. Line

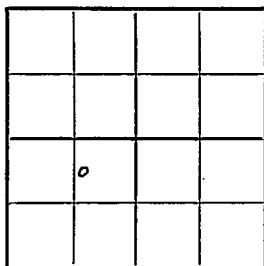

LINDSBORG POOL

Location

Rig up

Drilling and Remarks:

Sump. 3522
5-235-10
Via 3407
842 to 3405-17
Pump 178 R 8.
36 1/2 in

RECORD

Cased _____ in., _____ ft.

Sand _____

Gas _____

Oil _____

Total Depth 3542

PRODUCTION

1st 24 hrs. Nat. _____

1st 24 hrs. after shot _____

Gas _____ Cu. Ft.

Dry Hole _____

Abandoned _____

Date

APR 28 1943

19

S. J. LEWIS Scout