

KANSAS


McPherson

FORM 51 5M 10-41 PETROL

Section 36 Township 17 Range 4-W

Well No. #3 Bean

Company Auto Ordance

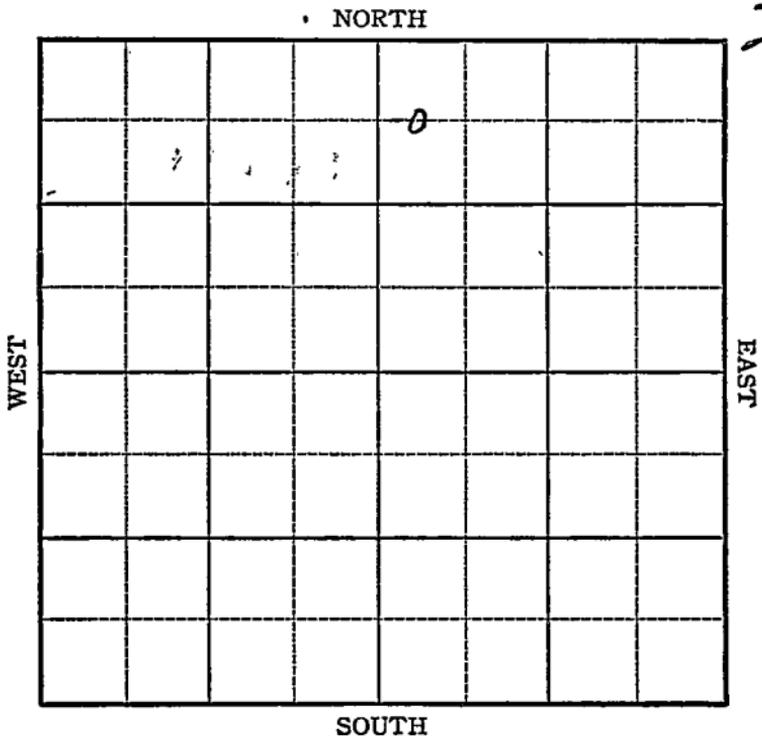

Sec. 36 Twp. 17 R. 4-W

Well No. #3 Bean Farm _____

Auto Ordnance Company _____


Lindsborg

660 Ft. from N. Line

_____ Ft. from S. Line

_____ Ft. from E. Line

330 Ft. from W. Line

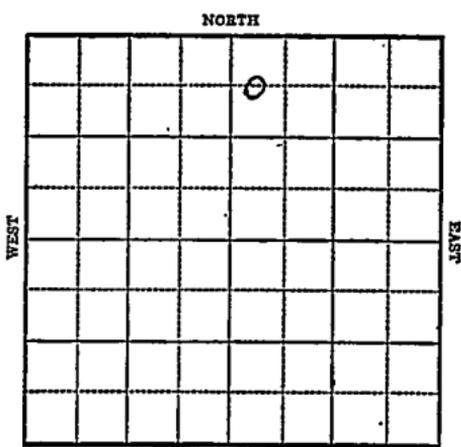

C WL NW NE 1348 DE 1345 G.V.

1943

R E P O R T

- 2/17 Rotary
- 2/24 12" Casing set 184
Drlg. 1476'
- 3/3 8" Casing set 383
Drlg. 2795'
- 3/10 Chat 2941
Viola 3389-97 TD SO
5" Casing 3389 RUST.
- 3/16 Swab $4\frac{1}{2}$ oil per hr 15 hrs.
- 3/24 Viola 3389
5" @ 3389'
T.D. 3397'
3300 gal. acid
Pump 56l Pot.
Gravity 36

COMPLETED

McPherson

~~KANSAS~~
 Map No. _____ Sec. 36 Twp. 17 R. 4W

Well No. 3 Bean

Auto Ordnance Company

FIRST REPORT Contractor

C WL NW NE

660 Ft. from N. Line

_____ Ft. from S. Line

_____ Ft. from E. Line

330 Ft. from W. Line

SECTION PLAT

		o	

LINDSBORG POOL

Location _____

Rig up _____

Drilling and Remarks:

Rotary

RECORD

Cased _____ in., _____ ft.

Sand _____

Gas _____

Oil _____

Total Depth _____

PRODUCTION

1st 24 hrs. Nat. _____

1st 24 hrs. after shot _____

Gas _____ Cu. Ft.

Dry Hole _____

Abandoned _____

Date

FEB 17 1943

19

S. J. LEWIS

Scout

KANSAS

Map No. 44 Sec. 36 Twp. 17 R. 4W

Well No. 3 Bean

Auto Ordnance Company

COMPLETED Contractor

C WL NW NE

SECTION PLAT

66.0 Ft. from N. Line

_____ Ft. from S. Line

_____ Ft. from E. Line

330 Ft. from W. Line

		0	

LINDSBORG POOL

Location _____

Rig up _____

Drilling and Remarks:

Via 3389
5" C 3389
3300 acid
Pump 561 Pst

36° G

RECORD

Cased _____ in., _____ ft.

Sand _____

Gas _____

Oil _____

Total Depth 3397

PRODUCTION

1st 24 hrs. Nat. _____

1st 24 hrs. after shot _____

Gas _____ Cu. Ft.

Dry Hole _____

Abandoned _____

Date

MAR 24 1943 19

S. J. LEWIS Scout