

KANSAS

McPherson

FORM 51 5M 10-41 PETROL

Section 36 Township 17 Range 4-W

Well No. #1 Bean Estate

Company Auto Ordnance


Lindsborg Pool

NORTH

WEST

EAST

SOUTH

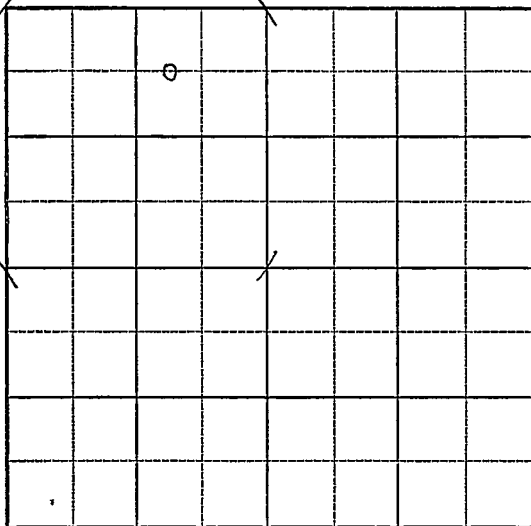

KANSAS

McPherson


Sec. 3 36. Twp. 17 R. 4-WWell No. #1 Bean Estate FarmAuto Ordnance Company

Lindsborg Pool

660 Ft. from N. Line Ft. from S. Line990 Ft. from E. Line Ft. from W. Line

C WL NE NW

Elev. 1351

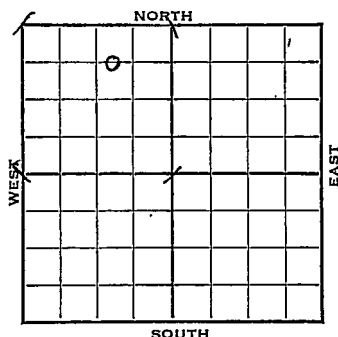

1942

REPORT

12/9 Loc.

12/16 15" @ 165
WOC

12/22 Drlg. 1875'

12/29 Miss. 2954 Drlg. 2989

1943

1/6

B. Miss 3176

Misener 3395

Viola 3397-7" casing set at 3397

T. D. 3399 $\frac{1}{2}$ --Rust.

1/13

TD 3403 $\frac{1}{2}$ '

Swab 16 bbls oil per hr. 2 hrs.

1/20

Viola 3397

7" Casing set 3397

3000 acid

Echo Pot 1915

36. Gravity.

TD 3403 $\frac{1}{2}$ '

COMPLETED

Map No. 44 Sec. 36 Twp. 17 R. 4WWell No. 1 Bean Estate

Auto Ordnance

Company

FIRST REPORT


Contractor

C WL NE NW

SECTION PLAT

660 Ft. from N. Line Ft. from S. Line990 Ft. from E. Line Ft. from W. Line

LINDSBORG POOL

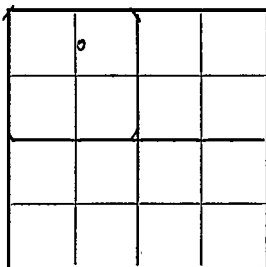Location XXXRig up

Drilling and Remarks:

RECORD

Cased in., ft.Sand Gas Oil Total Depth

PRODUCTION

1st 24 hrs. Nat. 1st 24 hrs. after shot Gas Cu. Ft.Dry Hole Abandoned

Date

DEC 9 1942 19S. J. LEWIS

Scout

KANSASMap No. Sec. 36 Twp. 17 R. 4WWell No. 1 **Bean Estate****Auto Ordnance**

Company

COMPLETED

Contractor

C WL NE NW660 Ft. from N. Line

Ft. from S. Line

990 Ft. from E. Line

Ft. from W. Line

SECTION PLAT

	0		

LINDSBORG POOLLocation Rig up

Drilling and Remarks:

*Vista 3397**7" @ 3397**3000 acid**Echo P & 1915**36 1/2 ft***RECORD**Cased in., ft.Sand Gas Oil Total Depth 3428 1/2**PRODUCTION**1st 24 hrs. Nat. 1st 24 hrs. after shot Gas Cu. Ft.Dry Hole Abandoned

Date

JAN 20 1943 19S. J. LEWIS Scout