

KANSAS

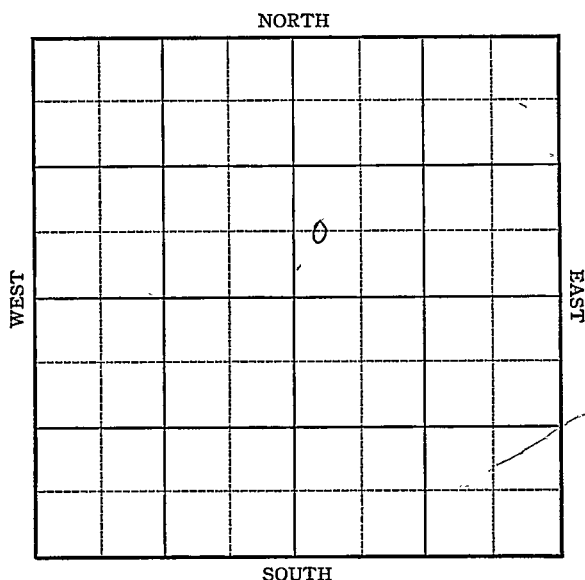
McPherson

FORM 51 5M 1-42 PETROL

Section 36 Township 17 Range 4-W

Well No. #1 Helander

Company Texas

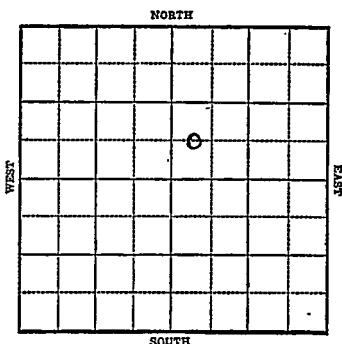


KANSAS

Barton

Sec. 36 Twp. 17 R. 4-WWell No. #1 Helander FarmTexas Company

Lindsborg

 Ft. from N. Line660 Ft. from S. Line Ft. from E. Line330
660 Ft. from W. Line*Elev. 1346*

1943

R E P O R T

3/17 Rotary.

3/24 "

3/31 10" @ 196 Drlg. 380

4/7 Drlg. 1500'

4/14 Miss 2931
Drlg. 3221'4/21 Misiner 3381
Viola 3382
Dimp Sd. 3529-51T.D.
5" @ 3463

Swab 251 oil in 13 hrs.

4/28 12 shots 3390-95
2500 acid swab 142 oil & 16
water in 24 hrs.

5/5 " " " "

5/12 " " " "

5/19 " " " "

5/26 " " " "

6/2 " " " "

6/9 Viola 3382

5" @ 3463'

Perf. Viola

2500 gal. acid.

T.D. 3531'

Pump 162 oil $\frac{1}{2}$ plus water.

Gravity 36

COMPLETED

KANSAS

McPherson

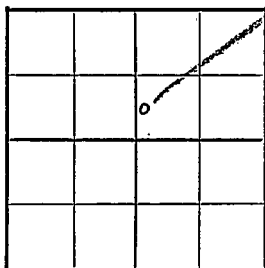
Map No. 44 Sec. 36 Twp. 17 R. 4WWell No. 1 HelanderTexas

Company

FIRST REPORT

Contractor

G WL SW NE

SECTION PLAT

Ft. from N. Line

660

Ft. from S. Line

Ft. from E. Line

660

Ft. from W. Line

LINDSBORG POOL

Location

Rig up

Drilling and Remarks:

Rotary

RECORD

Cased _____ in., _____ ft.

Sand _____

Gas _____

Oil _____

Total Depth _____

PRODUCTION

1st 24 hrs. Nat. _____

1st 24 hrs. after shot _____

Gas _____ Cu. Ft.

Dry Hole _____

Abandoned _____

Date

MAR 17 1943

19

S. J. LEWIS

Scout

Check spot and feet measurements
Advise

Sam

Misc Small Maps	
Cards	<i>Beats</i>
Tracing	<i>WMS</i>
France Map	<i>✓</i>
Scarborough Map	
Moody Map	<i>WMS</i>
Geological Dept.	
Moody Flat Book	

McPherson

KANSAS

Map No. 44 Sec. 36 Twp. 17 R. 4WWell No. 1 Helander

Texas

Company

CORRECTION

Contractor

C WL SW NE

SECTION PLAT

		0	

Ft. from N. Line

660

Ft. from S. Line

Ft. from E. Line

330

Ft. from W. Line

LINDSBORG POOL

Location

Rig up

Drilling and Remarks:

Reported

660 by 660

RECORD

Cased _____ in., _____ ft.

Sand _____

Gas _____

Oil _____

Total Depth _____

PRODUCTION

1st 24 hrs. Nat. _____

1st 24 hrs. after shot _____

Gas _____ Cu. Ft.

Dry Hole _____

Abandoned _____

Date

MAR 17 1943

19

S. I. LEWIS

Scout

Misc Small Maps
Cards *Boats*
Tracing *MB*
France Map *✓*
Scarborough Map *✓*
Moody Map *MB*
Geological Dept.
Moody Flat Book

McPherson

KANSAS

Map No. 44 Sec. 36 Twp. 17 R. 4WWell No. 1 Helander

Texas

Company

COMPLETED

Contractor

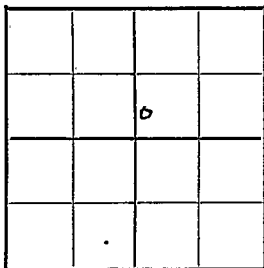
C WL SW NE

SECTION PLAT

_____ Ft. from N. Line

660 Ft. from S. Line

_____ Ft. from E. Line

660 Ft. from W. Line

LINDSBORG POOL

Location _____

Rig up _____

Drilling and Remarks:

*Vista 3382**5-1103463**Per Vista**2500 acid**Pump 162 oil 17**Water 360 gal*

RECORD

Cased _____ in., _____ ft.

Sand _____

Gas _____

Oil _____

Total Depth 3531

PRODUCTION

1st 24 hrs. Nat. _____

1st 24 hrs. after shot _____

Gas _____ Cu. Ft.

Dry Hole _____

Abandoned _____

Date

JUN 9 1943 19

S. J. LEWIS Scout

Misc. Small Maps

Cards

Tracing

France Map

Scarborough Map

Moody Map

Geological Dept.

Moody Map Book