


KANSAS

McPherson

Section 36 Township 17 Range 4-W

Well No. #3 Helander

Company Texas

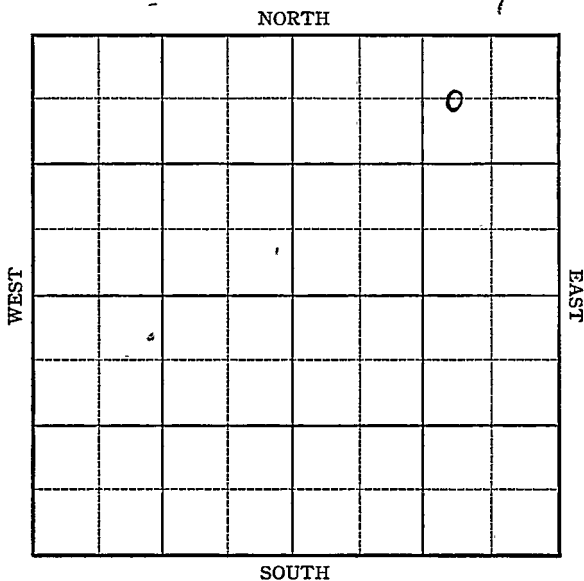


KANSAS

McPherson

Sec. 36 Twp. 17 R. 4-WWell No. #3 Helander FarmTexas Company

Lindsborg

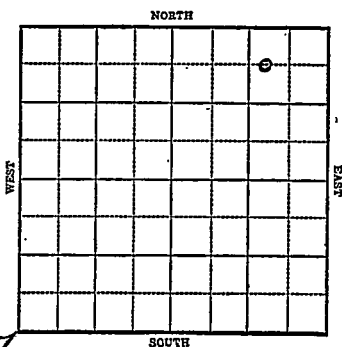660 Ft. from N. Line Ft. from S. Line990 Ft. from E. Line Ft. from W. Line*Elev. 1347*

1943

R E P O R T

5/26

Location.

6/2

12" @ 189
Drlg. 360

6/9

8" @ 405
Drlg. 1701

6/16

Miss 2920
Viola 3378-79 T.D.
5" @ 3374 Rust

6/23

" " "

6/30

Viola 3378
5" @ 3374'
T.D. 3392'
500 acid
Pump 187 Pot
Gravity 36**COMPLETED**

KANSAS

McPherson

Map No. 47 Sec. 36 Twp. 17 R. 4WWell No. 3 Helander

Texas

Company

FIRST REPORT

Contractor

C WL NE NE

SECTION PLAT

			0

660 Ft. from N. Line Ft. from S. Line990 Ft. from E. Line Ft. from W. Line

LINDSBORG POOL

Location XXXXXRig up

Drilling and Remarks:

RECORD

Cased in., ft.Sand Gas Oil Total Depth

PRODUCTION

1st 24 hrs. Nat. 1st 24 hrs. after shot Gas Cu. Ft.Dry Hole Abandoned

Date

MAY 26 1943 19S. J. LEWIS

Scout

KANSAS

McPherson

Map No. 44 Sec. 36 Twp. 17 R. 4WWell No. 3 Helander

Texas

Company

COMPLETED

Contractor

C WL NE NE

SECTION PLAT

660 Ft. from N. Line Ft. from S. Line990 Ft. from E. Line Ft. from W. Line

LINDSBORG POOL

Location

Rig up

Drilling and Remarks:

Vista 3378
5' 03374
500 cuil
Pump 187 Pst

36° 42'

RECORD

Cased in., ft.Sand Gas Oil Total Depth 13392

PRODUCTION

1st 24 hrs. Nat. 1st 24 hrs. after shot Gas Cu. Ft.Dry Hole Abandoned

Date

JUN 3 0 1943 19

S. J. LEWIS Scout