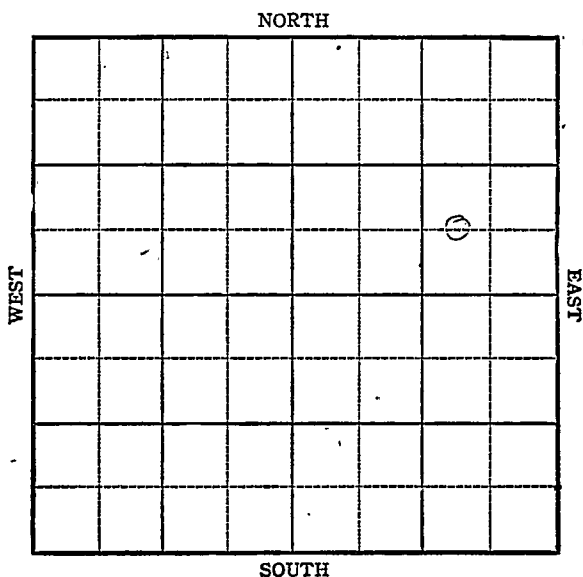


KANSAS

Mcpherson

FORM 51 5M BRIX

Section 36 Township 17 Range 4WWell No. #6, HelanderCompany Texas

McPherson

Sec. 36 Twp. 17 R. 4W

Well No. #6 Helander Farm

Texas Company

Lindsborg


 Ft. from N. Line

660 Ft. from S. Line

990 Ft. from E. Line

 Ft. from W. Line

Elev. 1349

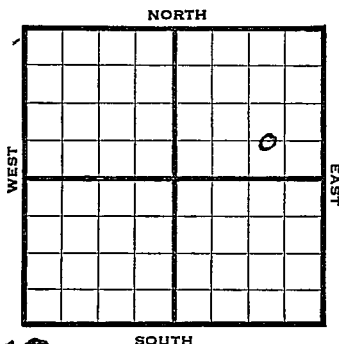

1944

R E P O R T

5/24

Location

5/31

8" @ 185 - 404 WOC

6/7

Drlg. 2640'

6/15

Viola 3383

TD 3384

5" @ 3384 Rust

6/21

TD 3400-500 acid

Swab 4 oil per hr.

6/28

5" @ 3384

Viola 3383

TD 3400

1500 acid

Pump 99 Pot.

36.2 Gravity

KANSASPool Name LindsborgMap No. 1 Sec. 36 Twp. 17 R. 4WWell No. 6 HelanderTexas

Company

FIRST REPORT

Contractor

C W L S E N E**SECTION PLAT**

			o

 Ft. from N. Line660 Ft. from S. Line990 Ft. from E. Line Ft. from W. LineMcPherson CountyLocation XRig up

Drilling and Remarks:

RECORDCased in., ft.Sand Gas Oil Total Depth **PRODUCTION**1st 24 hrs. Nat. 1st 24 hrs. after shot Gas Cu. Ft.Dry Hole Abandoned

Date

MAY 24 194419S. J. LEWIS Scout

KANSAS

Pool Name LindsborgMap No. 44 Sec. 36 Twp. 17 R. 4WWell No. 6 HelanderTexas

Company

COMPLETED

Contractor

C W L S E N E

SECTION PLAT

			5

Ft. from N. Line660 Ft. from S. Line990 Ft. from E. LineFt. from W. LineMcPherson County

Location

Rig up

Drilling and Remarks:

*Vista 3383**5 C 3384,**1500 acid**Pump 99 P & T**36 2/3*

RECORD

Cased _____ in., _____ ft.

Sand _____

Gas _____

Oil _____

Total Depth 3400

PRODUCTION

1st 24 hrs. Nat. _____

1st 24 hrs. after shot _____

Gas _____ Cu. Ft.

Dry Hole _____

Abandoned _____

Date

JUN 28 1944 19S. J. LEWIS Scout