


Section 36 Township 17 Range 6 W

Well No. # 1 Peterson

Company Trans-Era & Nate Appleman

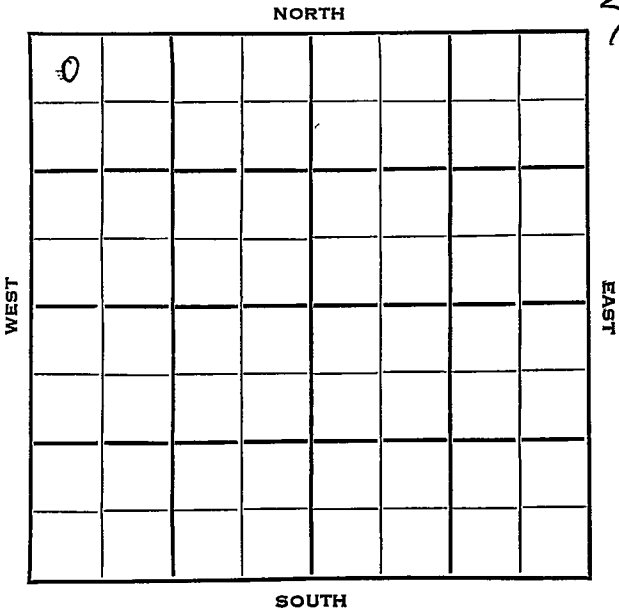

Ellsworth

KANSAS

SEC.	TWP.	R.
36	17	6W

WELL NO. #1 Peterson FARM
 COMPANY

CONTRACTOR Trans Era & Nate Appleman


Wildcat.

330 Ft. from N. Line

Ft. from S. Line

Ft. from E. Line

330 Ft. from W. Line

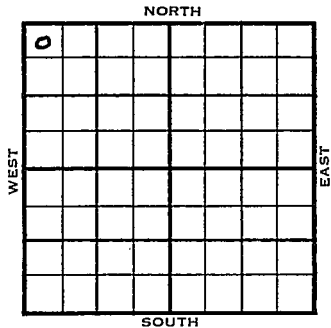

NW NWNW
Skelly support.

1953	ELEVATION 1606'	REPORT
------	--------------------	--------

11/30 M I R
 12/9 8" @ 192 Drlg. 2680
 12/16 Spud 12-2-53 D & A TD 3471'
 8" @ 192 Lans. 2745' Miss 3345.
 Kh. 3436
 DST 3202-3471 open 1 hr rec 1410' SW
 1175# TD 3471'
 D & A

ABANDONED

County Ellsworth State Kansas

Sec. 36 (Blk.) 17 (Sur.) 6W Map No.

Operator Trans-Era & Hato Appelman

Well No. 1 Farm Peterson

Elev. _____ Location NE 1/4 Sec 36 Twp 17 N R 6 W

0					
FIRST REPORT					

330 Ft. From N Line NE

330 Ft. From 1/4 Line Quarter

1st. Report DEC 2 1953

Completion _____

Remarks Skelly support

Spudding Date _____

Drig. Data Wildcat

W I R

J. G. McGEHEE

County Ellsworth State Kansas
 Sec. 36 (Blk. 17 (Sur. 6W (Twp.) 17 (Rge.) 6W Map No.
 Operator Trans-Era & Nate Appleman
 Well No. 1 Farm Peterson
 Elev. 1606 Location NW NW NW

σ					

330 Ft. From N Line NW
330 Ft. From W Line Quarter

1st. Report

Completion DEC 16 1953

Remarks Wildcat

Spudding Date 12-2-53

Drilg. Data D & A TD 3471

8" @ 192 Lans. 2745 Miss. 3345

Kh. 3436 DST 3202-3471 open 1 hr.

Rec. 1410' sw 1175# TD 3471

D & A

J. G. McGEHEE