

Section 36 Township 17 Range 2WWell No. 1 Robinson "A"Company Derby Oil & Carey

Twin Mound Pool

NORTH

WEST

							0

SOUTH

EAST

16

Sec. 36 Twp. 17 R. 2W

Well No. #1 Robinson "A" Farm

D Derby Oil & Carey Company

(Twin Mound Pool) (Carey, Cont.)


 Ft. from N. Line

330' Ft. from S. Line

330' Ft. from E. Line

 Ft. from W. Line

SE/C

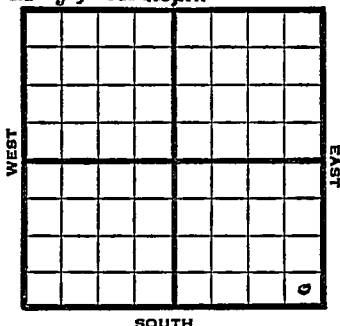

1949 Elev 1373' REPORT

9/21	8" @ 1260'
9/28	KC 2145'
	Miss 2736'
	TD 2739
	5" @ 2737'
10/5	"
10/12	"
10/19	"
10/26	"
11/1	"
11/9	TD 2739'
	KC 2145'
	Miss 2736'
	5" @ 2737'
	Pump 472 Oil Pot
	36° Gr.
	Comp

COMPLETED

Kansas

Twin Mound Pool

Map No. _____ Sec. 36 Twp. 17 R. 2WWell No. 1 Robinson "A"

Derby Oil & Carey _____ Company

Carey _____ Contractor

SE/C

FIRST REPORT
SECTION PLAT

_____ Ft. from N. Line

330 _____ Ft. from S. Line330 _____ Ft. from E. Line

_____ Ft. from W. Line

McPherson County

RECORD

Location _____

Cased _____ in., _____ ft.

Rig up _____

Sand _____

Drilling and Remarks:

Gas _____

8" @ 1260

Oil _____

Total Depth _____

PRODUCTION

1st 24 hrs. Nat. _____

1st 24 hrs. after shot _____

Gas _____ Cu. Ft.

Dry Hole _____

Abandoned _____

Date

SEP 21 1949 19S. J. LEWIS Scout

Kansas

Map No. _____ Sec. 36 Twp. 17 R. 2WWell No. 1 Robinson "A"

Derby Oil & Carey Company

COMPLETE

Contractor

SE/C

E1, 1328
SECTION PLAT

_____ Ft. from N. Line

330 Ft. from S. Line330 Ft. from E. Line

_____ Ft. from W. Line

			0

McPherson County

Location _____

Rig up _____

Drilling and Remarks:

*KC 2145**Misc 2236**5' C 2737**Pump 472 oil 808**36 2/4*

RECORD

Cased _____ in., _____ ft.

Sand _____

Gas _____

Oil _____

Total Depth 2739

PRODUCTION

1st 24 hrs. Nat. _____

1st 24 hrs. after shot _____

Gas _____ Cu. Ft.

Dry Hole _____

Abandoned _____

Date

NOV 9 1949 19

S. J. LEWIS Scout