

Section 36 Township 17 Range 2WWell No. 1 TarnstromCompany Casebeer & Litan

NORTH

13

	0						

SOUTH

WEST

EAST

McPherson KANSAS

Sec. 36 Twp. 17 R. 2W

Well No. #1 Tarnstrom Farm

Casebeer & Litan Company

Carey Drlg. Contractor


Ft. from N. Line

330 Ft. from S. Line

Ft. from E. Line

990 Ft. from W. Line

SE SW SW

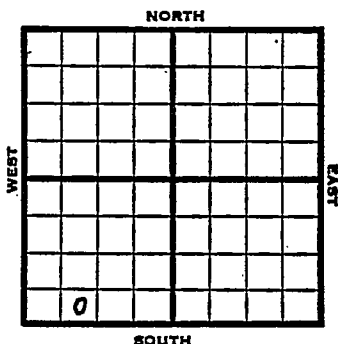

1953 Elev. 1389! REPORT

1/14 RUR
1/22 8" @ 140
Drlg. 1585'
1/29 Lans 2160, Burgess 2769, Miss
Chert 2777
RTD 2779
5" @ 2776, WOC
2/4 Spud 1-5-53
D&A
TD 2788
8" @ 140
Lans 2160, Burgess 2769, Miss
2777
TD 2779
5" @ 2776
CO to 2779 HFW DD 2788
PB 2776 9/2771-75 HFW
D&A

ABANDONED

County **McPherson** State **Kansas**

Sec. 36 (Blk. 17 (Sur. 2W Map No.

Operator **Casebeer & Litan**

Well No. **1** Form **Tarnstrom**

Elev.	Location	SE	SW	SW
-------	----------	----	----	----

330 Ft. From S Line SW

990 Ft. From W Line Quarter

1st. Report JAN 14 1953

Completion

Remarks

Carey Drlg. - Contr.


Spudding Date . . .

Drlg. Data

R U R

J. G. McGEHEE

County McPherson State Kansas
 Sec. 36 (Blk. 17 (Sur. 2W Map No.
 (Twp. (Rge.
 Operator Casebeer & Litan
 Well No. 1 Farm Tarnstrom
 Elev. 1389 Location SE SW SW

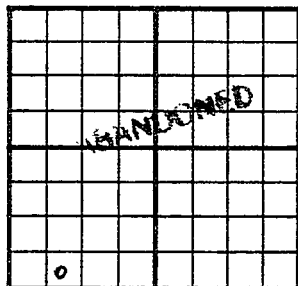

330 Ft. From S Line SW
990 Ft. From W Line Quarter

1st. Report

Completion FEB 4 1953

Remarks

Carey Drlg. - Contr.

Spudding Date 1-5-53

Drlg. Data D & A TD 2788

8" @ 140 Lens. 2160 Burgess 2769

Miss. 2777 TD 2779 5" @ 2776

CO to 2779 HFW DD 2788 PB 2776

9/ 2771-75 HFW

D & A

J. G. McGEHEE