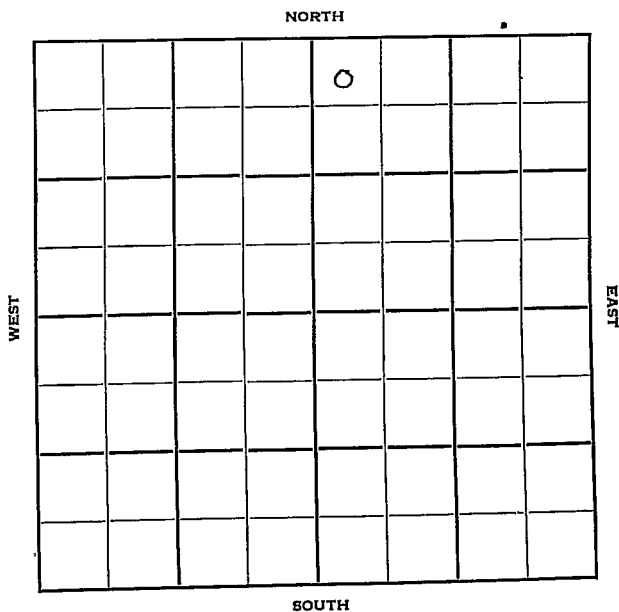


Section 4 Township 17 Range 10WWell No. #3 Stoltenberg "C"Company Cities Service

Ellsworth **KANSAS**

Sec. 4 Twp. 17 R. 10W ✓

Well No. #3 Stoltenberg "C" Farm

Cities Service Company

Contractor


330' Ft. from N. Line

Ft. from S. Line

Ft. from E. Line

330' Ft. from W. Line

NW NW NE

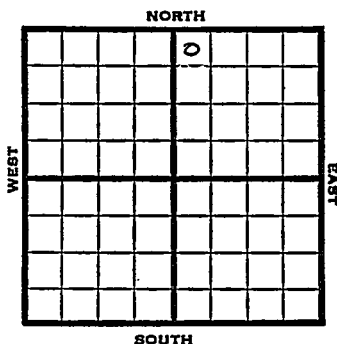

1951 Elev. 1829' REPORT

8/22 RUR

9/12 Spud 8-21-51 Oil well TD 3306'
8" @ 355' Lans. 2945' Cong 3266'
Arb. 3297-99' 5" @ 3298'
CO to 3306'
Comp. 151 BOPD

COMPLETED

County Ellsworth State KansasSec. 4 (Blk. Twp.) 17 (Sur. Rge.) 10W Map No.Operator Cities ServiceWell No. 3 Farm Stoltenberg "C"Elev. Location NW NW NE

				0			

FIRST REPORT

330 Ft. From N Line NR330 Ft. From W Line Quarter1st. Report AUG 22 1951

Completion

Remarks

Spudding Date

Drig. Data

R U R

J. E. TYRA

J. E. TYRA