

KANSAS Ellsworth


FORM 51 25M 3-49 PETROL

Section 4 Township 17 Range 10-W

Well No. #²~~1~~ Ehler

Company B & R

Stoltenberg Pool
NORTH

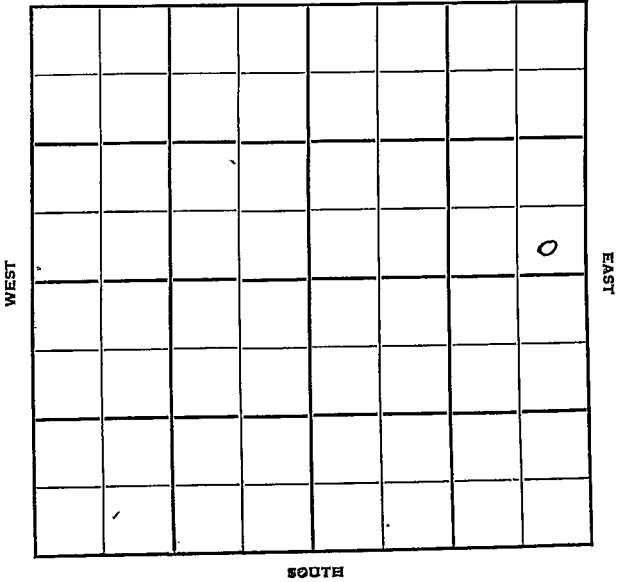

Sec. 4 Twp. 17 R. 10W

Well No. #1 Ehler Farm

B & R Drlg.

Company

B & R

Contractor

Stoltenberg Pool

Ft. from N. Line

330'


Ft. from S. Line

330'

Ft. from E. Line

Ft. from W. Line

SE NE

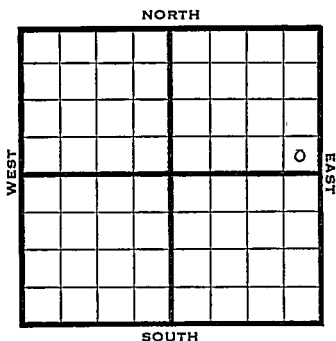

1949 Elev 1806' REPORT

10/26

8" @ 384'

Arb 3273'

TD 3279

5" @ 3274'

Acid 5000

11/1

TD 3284'

11/9

"

11/16

TD 3284'

Arb. 3273'

5" @ 3274'

5000 acid

Pump 38 Oil Pot

42° Gr.

Comp

COMPLETED

Kansas

Stoltenberg Pool

Map No. _____ Sec. 4 Twp. 17 R. 10WWell No. 2 Ehler

B & R Drlg. _____ Company

CORRECTION

Contractor _____

SE NE

SECTION PLAT

_____ Ft. from N. Line

330 Ft. from S. Line330 Ft. from E. Line

_____ Ft. from W. Line

Ellsworth County

Location _____

Rig up _____

Drilling and Remarks:

Reported as
#1 Ehler**RECORD**

Cased _____ in., _____ ft.

Sand _____

Gas _____

Oil _____

Total Depth _____

PRODUCTION

1st 24 hrs. Nat. _____

1st 24 hrs. after shot _____

Gas _____ Cu. Ft.

Dry Hole _____

Abandoned _____

Date

OCT 26 1949 19S. J. LEWIS

Scout

Map No. _____ Sec. 4 Twp. 17 R. 10W

Well No. 1 Ehler

_____ B & R Drlg. _____ Company

_____ B & R _____ Contractor

SE NE

**FIRST REPORT
SECTION PLAT**

_____ Ft. from N. Line

330 Ft. from S. Line

330 Ft. from E. Line

_____ Ft. from W. Line

Ellsworth County

Location _____

Rig up _____

Drilling and Remarks: -

8" @ 384

Arb. 3273

TD 3279

5" @ 3274

5000 acid

RECORD

Cased _____ in. _____ ft.

Sand _____

Gas _____

Oil _____

Total Depth _____

PRODUCTION

1st 24 hrs. Nat. _____

1st 24 hrs. after shot _____

Gas _____ Cu. Ft.

Dry Hole _____

Abandoned _____

Date

OCT 26 1949

19

S. J. LEWIS Scout

Map No. _____ Sec. 4 Twp. 17 R. 10W

Well No. 2 Ehler

_____ B & R Drlg. _____ Company

COMPLETE

Contractor

SE NE

E11806
SECTION PLAT

_____ Ft. from N. Line

330 Ft. from S. Line

330 Ft. from E. Line

_____ Ft. from W. Line

Ellsworth County

Location _____

Rig up _____

Drilling and Remarks:

Per 83223

5" C3274

5000 acid

Per 38 oil Rd.

42.2 lb

RECORD

Cased _____ in., _____ ft.

Sand _____

Gas _____

Oil _____

Total Depth 3284

PRODUCTION

1st 24 hrs. Nat. _____

1st 24 hrs. after shot _____

Gas _____ Cu. Ft.

Dry Hole _____

Abandoned _____

Date

NOV 16 1949

19

S. J. LEWIS

Scout