


Section 4 Township 17 Range 10W

Well No. #3 Ehler

Company B & R Drlg.

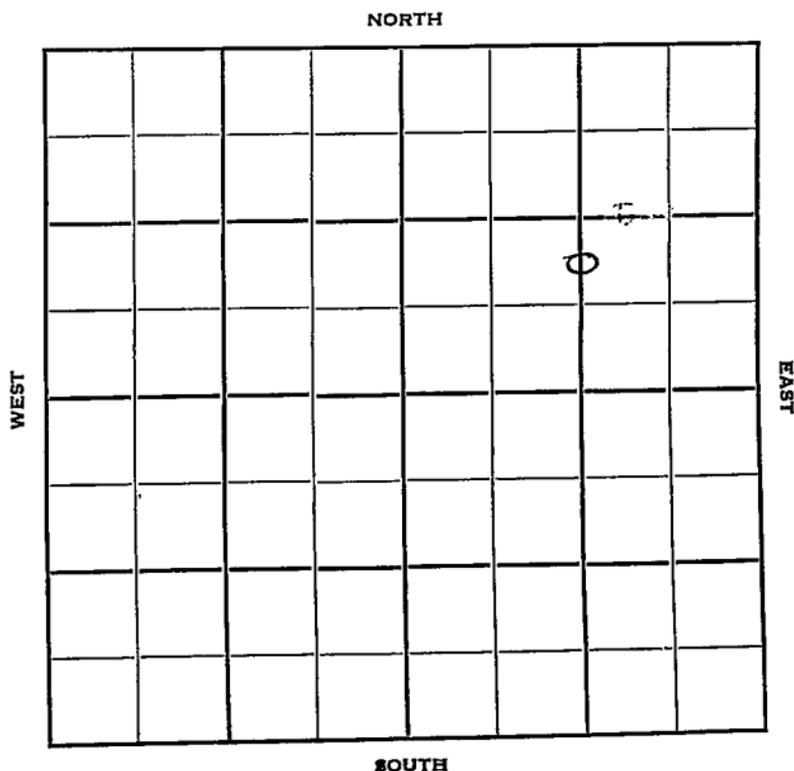

Sec. 4 Twp. 17 R. 10W

Well No. #3 Ehler Farm

B & R Drlg Company

Contractor


Ft. from N. Line

990' Ft. from S. Line

1320' Ft. from E. Line

Ft. from W. Line

C N $\frac{1}{2}$  S $\frac{1}{2}$  NE

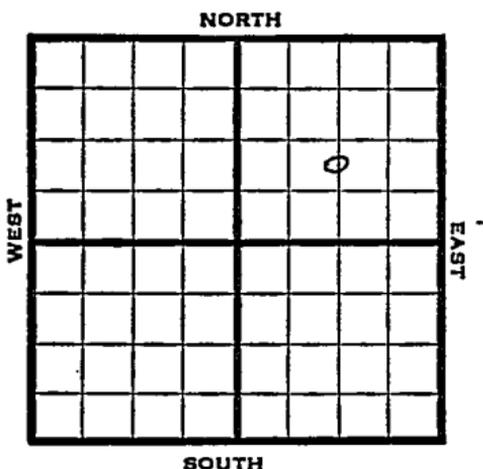

1950 Elev. 1823' REPORT

5/3 Spud 2-27-50  
8-5/8" @ 370'  
Anhy 590-620  
Drlg. 2458'

5/24 8 5/8" @ 370  
Anhy 590-620  
Arb 3304-12  
5" @ 3310  
500 acid  
bail 5 gal oil ph  
1500 acid wtr  
D&A

**ABANDONED**

Kansas

Map No. \_\_\_\_\_ Sec. 4 Twp. 17 R. 10WWell No. 3 Ehler

\_\_\_\_\_ B &amp; R Drlg. \_\_\_\_\_ Company

\_\_\_\_\_ Contractor


C  $N\frac{1}{2}$   $S\frac{1}{2}$  NEE. 1823  
SECTION PLAT

\_\_\_\_\_ Ft. from N. Line

990 Ft. from S. Line1320 Ft. from E. Line

\_\_\_\_\_ Ft. from W. Line

Ellsworth County

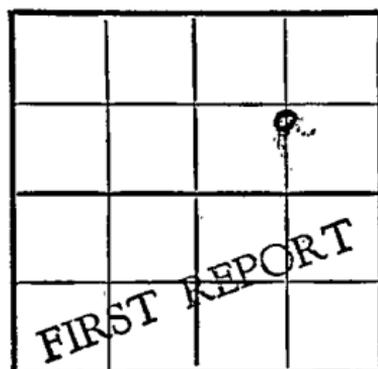

Location \_\_\_\_\_

Rig up \_\_\_\_\_

Drilling and Remarks:

Spud 4-27-50

8 5/8" @ 370'

Anhy 590-620

drlg. 2458

## RECORD

Cased \_\_\_\_\_ in., \_\_\_\_\_ ft.

Sand \_\_\_\_\_

Gas \_\_\_\_\_

Oil \_\_\_\_\_

Total Depth \_\_\_\_\_

## PRODUCTION

1st 24 hrs. Nat. \_\_\_\_\_

1st 24 hrs. after shot \_\_\_\_\_

Gas \_\_\_\_\_ Cu. Ft.

Dry Hole \_\_\_\_\_

Abandoned \_\_\_\_\_

Date

MAY 3 1950 19 \_\_\_\_\_

J. E. TYRA

Scout

Kansas

Map No. \_\_\_\_\_ Sec. 4 Twp. 17 R. 10WWell No. 3 EhlerB & R Drlg. Company

Contractor

C  $N\frac{1}{2}$  S  $S\frac{1}{2}$  NEEl. 1823  
SECTION PLAT

\_\_\_\_\_ Ft. from N. Line

990 Ft. from S. Line1320 Ft. from E. Line

\_\_\_\_\_ Ft. from W. Line

			○
ABANDONED			

Ellsworth

Location \_\_\_\_\_

Rig up \_\_\_\_\_

Drilling and Remarks:

8 5/8" @ 370anhy 590-620arb 3304-125" @ 3310500 acidBail 5 gal oil jhs.1500 acid waterDate D + A

## RECORD

Cased \_\_\_\_\_ in., \_\_\_\_\_ ft.

Sand \_\_\_\_\_

Gas \_\_\_\_\_

Oil \_\_\_\_\_

Total Depth X

## PRODUCTION

1st 24 hrs. Nat. \_\_\_\_\_

1st 24 hrs. after shot \_\_\_\_\_

Gas \_\_\_\_\_ Cu. Ft.

Dry Hole \_\_\_\_\_

Abandoned \_\_\_\_\_

MAY 24 1950

19

J. E. TYRA Scout