

Ellsworth


Andrews

DX 78-1

Section 4 Township 17 Range 8W

Well No. #1 Andrews

Company Rocket Drlg.

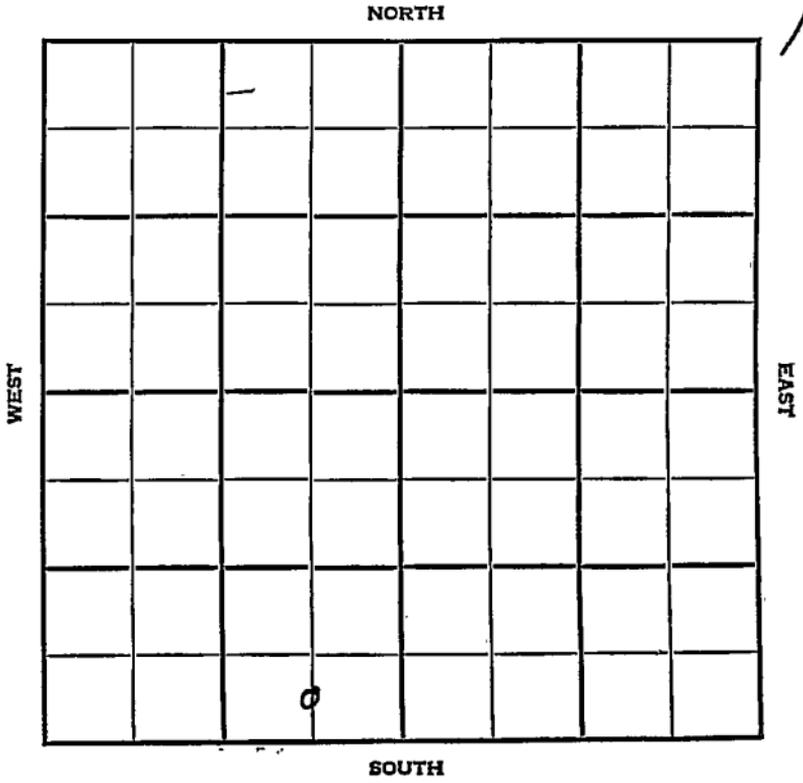

Ellsworth KANSAS

SEC. <div style="text-align: center; font-size: 24pt;">4</div>	TWP. <div style="text-align: center; font-size: 24pt;">17</div>	R. <div style="text-align: center; font-size: 24pt;">8W</div>
WELL NO. <div style="text-align: center; font-size: 24pt;">1 Andrews</div>		
COMPANY <div style="text-align: center; font-size: 24pt;">Rocket Drlg.</div>		FARM
CONTRACTOR <div style="text-align: center; font-size: 24pt;">Co. tools</div>		


Geneseo- Edwards

_____ Ft. from N. Line

330 _____ Ft. from S. Line

660 _____ Ft. from E. Line

_____ Ft. from W. Line

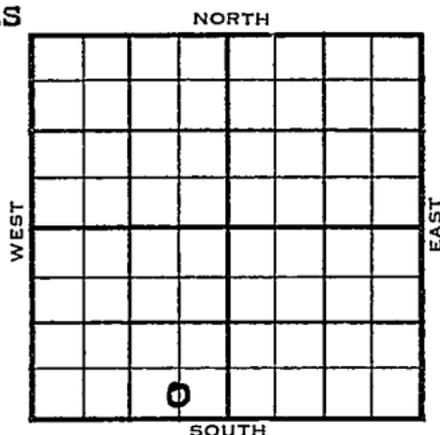

C S $\frac{1}{2}$ SE SW

1954	ELEVATION 1677'	REPORT
------	--------------------	--------

8-25	M I R
10/27	Spud 8-25-54 Oil Well TD 3206' 8-5/8" @ 231' Heeb 2603', Br. Lime 2724', Lans 2742' B KC 3063', Simp 3151', Cong 3105' DST 3155'-99' opn 1 hr, rec 10' Mud, B30# Arb. 3200' TD 3202' 5" @ 3201' DD 3206' 1 boph 500 A S / 17 bo 7 hr. S/ 2 $\frac{1}{2}$ boph P/ 2 $\frac{1}{2}$ boph Comp 231 bopd

COMPLETED

County Ellsworth State Kansas

Sec. 4 (Blk.) 17 (Sur. Rge.) 8W Map No.

Operator Rocket Drlg.

Well No. 1 Farm Andrews

Elev. 1677 Location C S $\frac{1}{2}$ SE SW

330 Ft. From S Line SW

660 Ft. From E Line Quarter

Ist. Report

Completion OCT 27 1954

Remarks Geneseo-Edwards Pool

Co. tools

Spudding Date 8-25-54

Drlg. Data Oil well TD 3206

8 5/8" @ 231 Heeb. 2603 Br. lime 2724

Lans. 2742 B KC 3063 Simp. 3151

Cong. 3105 DST 3155-99 open 1 hr.

Rec. 10' mud 830# Arb. 3200 TD 3202

5" @ 3201 DD 3206 1 boph 500 A

S/ 17 bo 7 hr. S/ 2 $\frac{1}{2}$ boph P/ 2 $\frac{1}{2}$ boph

Comp. 231 bopd