


Section 4 Township 17 Range 8W

Well No. #1 Andrews

Company Eldorado Refg.

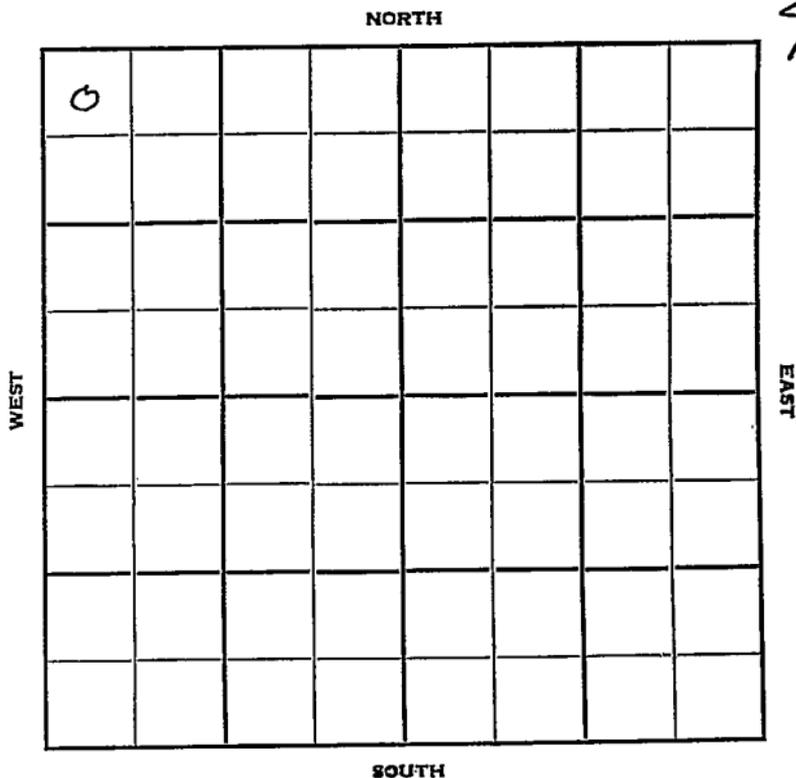

Sec. 4 Twp. 17 R. 8W

Well No. #1 Andrews Farm

Eldorado Refg. Company

Sterling Contractor

Wildcat


330 Ft. from N. Line

\_\_\_\_\_ Ft. from S. Line

\_\_\_\_\_ Ft. from E. Line

330 Ft. from W. Line

NW NW NW

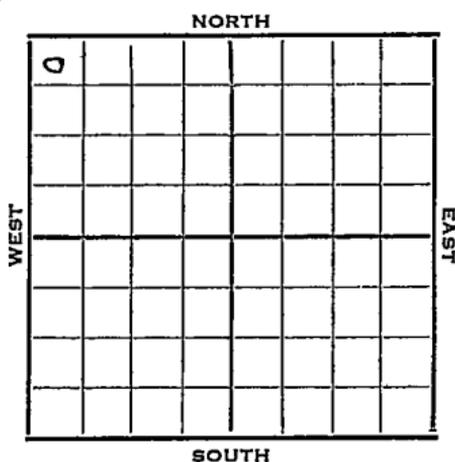

1952

Elev. 1690' REPORT

8/20

Spud 8-16-52  
Tite hole Drlg.

8/27  
9/3

"  
Heeb. 2613 Tor. 2635  
Br Li 2740 Lans. 2765  
DST 3055-75, 1/2 hr. 17'm 3'ocm  
B KC 3075 Cong. 3105  
Mq. 3134 \* V. 3190  
Simp. 3233 Arb. 3301  
DST 3302-05, 1 hr. 170' oil 30' wtr.  
900# TD 3305 5" @ 3302 CO 3305  
fill up 900' oil 14 hrs. S/ 2 Boph  
for 4 hrs.

9/10  
9/17  
9/24

Fill up 2440' oil 36 hrs. POP  
NR  
"

10/1

Spud 8-16-52  
Oil well TD 3305' Heeb 2613'  
Tor. 2635' Br. lime 2740' Lans 2765'  
DST 3055-75 open 1/2 hr. rec 17' mud 3'  
OCM O# B KC 3075' Cong. 3105'  
Maq. 3134' Viola 3190' Simp 3233'  
Arb. 3301'  
DST 3302-05 open 1 hr. rec 170' oil  
30' wtr. 900# TD 3305' 5" @ 3302  
CO to 3305' FU 900' oil 14 hr.  
S/2 BOPH FU 2440' oil 36 hr.  
Comp. 132 BOPD

**COMPLETED**


County **Ellsworth** State **Kansas**

Sec. **4** (Blk.) **17** (Sur.) **8W** Map No.

Operator **Eldorado Refg.**

Well No. **1** Farm **Andrew**

Elev. Location **NW NW NW**

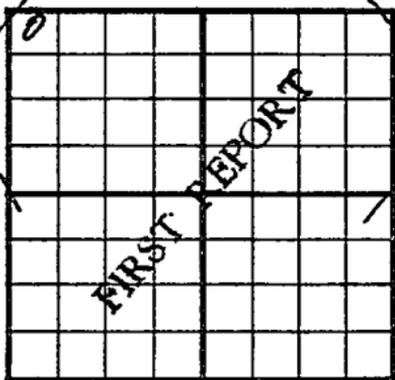

**330** Ft. From **N** Line **NW**

**330** Ft. From **N** Line Quarter

1st. Report **AUG 20 1952**

Completion

Remarks

**Sterling - Contr.**

Spudding Date **8-16-52**

Drig. Data **Wildcat**

**Title hole Drig.**

**J. G. McGEHEE**


County Ellsworth State Kansas

Sec. 4 (Blk. Twp.) 17 (Sur. Rge.) 8W Map No.

Operator Eldorado Ref.

Well No. 1 Farm Andrews

Elev. 1690 Location NW NW NW

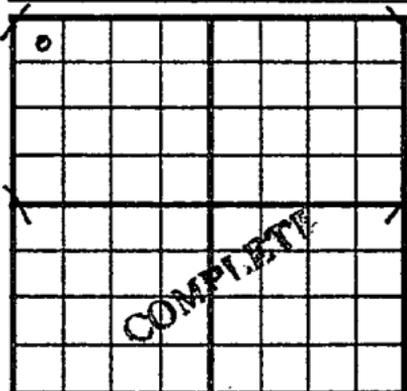

330 Ft. From N Line NW

330 Ft. From W Line Quarter

1st. Report

Completion OCT 1 1952

Remarks Andrews Pool

Sterling Drlg. - Contr.

Spudding Date 8-16-52

Drlg. Data Oil well TD 3305

Heeb. 2613 Tor. 2635 Br. line 2740

Lans. 2765 DST 3055-75 open  $\frac{1}{2}$  hr.

Rec. 17' mud 3' ocm 0# B KC 3075

Cmg. 3105 Maq. 3134 Viola 3190

Simp. 3233 Arb. 3301 DST 3302-05

open 1 hr. Rec. 170' oil 30' wtr. 900#

TD 3305 5" @ 3302 CO to 3305

FU 900' oil 14 hr. S/ 2 boph FU 2440'

oil 36 hr. Comp. 132 bond

J. G. McGEHEE