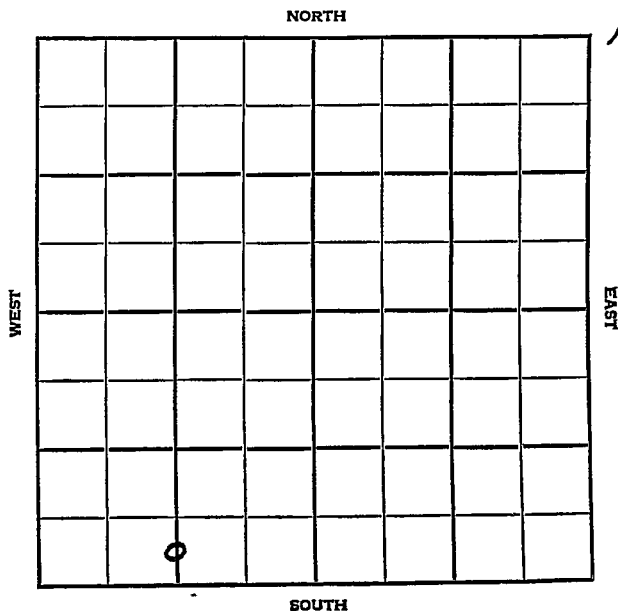


DX 78-1

Ellsworth KANSAS

Section 4 Township 17 Range 8W  
Well No. 2 Andrews  
Company Rocket Drlg.



Ellsworth

KANSAS

|             |      |      |
|-------------|------|------|
| SEC.        | TWP. | R.   |
| 4           | 17   | 8 W  |
| WELL NO.    |      |      |
| # 2 Andrews |      | FARM |
| COMPANY     |      |      |

Rocket Drlg.

CONTRACTOR

Co. tools

Geneseo-Edwards Pool

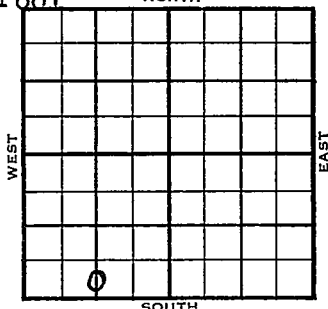
NORTH

Ft. from N. Line

330 Ft. from S. Line

Ft. from E. Line

1320 Ft. from W. Line

C S $\frac{1}{2}$  S $\frac{1}{2}$  SW

Continental FO

|      | ELEVATION   | REPORT |
|------|---|--------|
| 1955 | 1675'   |        |
| 1/12 | Spud 1-7-55<br>8" @ 217<br>Drlg. 2415'   |        |
| 2/23 | Spud 1-7-55<br>Oil Well<br>TD 3210'<br>8" @ 217'<br>Heeb 2594', Br. Lime 2712' Lans<br>2730'<br>DST 2746'-2845' opn 1 $\frac{1}{2}$ hr, rec 1560'<br>gas, 690' msw 980#<br>Simp 3145'<br>DST 3151'-97' opn 1 hr, rec 30' Mud<br>900# Arb. 3207'<br>TD3208'<br>5" @ 3208'<br>DD 3210'<br>1 $\frac{1}{2}$ boph 500 A P/ 11 boph<br>Comp 438 bopd. |        |

COMPLETED

County Ellsworth State Kansas  
 Sec. 4 (Blk.) 17 (Sur.) 8W Map No.

Operator Rocket Drig.

Well No. 2 Farm Andrews

Elev. Location C S  $\frac{1}{2}$  S  $\frac{1}{2}$  SW

|  |  |  |  |  |  |  |  |
|--|--|--|--|--|--|--|--|
|  |  |  |  |  |  |  |  |
|  |  |  |  |  |  |  |  |
330 Ft. From S Line SW

1320 Ft. From W Line Quarter

1st. Report JAN 1 2 1955

Completion

Remarks Continental farmout

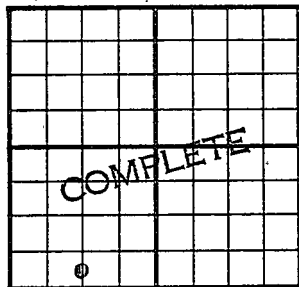
Co. tools

Spudding Date 1-7-55

Drig. Data Genesee-Edwards Pool

8" @ 217 drlg. 2415

FABEN GU STRAP

County Ellsworth State KansasSec. 4 (Blk.) 17 (Sur.) 8W Map No.Operator Rocket Drlg.Well No. 2 Farm AndrewsElev. 1675 Location C S $\frac{1}{2}$  S $\frac{1}{2}$  SW330 Ft. From S Line SW1320 Ft. From W Line Quarter

1st. Report

Completion FEB 23 1955Remarks Geneseo-Edwards PoolCo. toolsSpudding Date 1-7-55Drlg. Data Oil well TD 32108" @ 217 Heeb. 2594 Br. lime 2712Lans. 2730 DST 2746-2845 open 1 $\frac{1}{2}$  hr.Rec. 1560' gas 690' msw 980#Simp. 3145 DST 3151-97 open 1 hr.Rec. 30' mud 900# Arb. 3207TD 3208 5" @ 3208 DD 3210  $\frac{1}{2}$  boph500 A P/ 11 boph Comp. 438 bopd

FABEN GILSTRAP