

Section 4 Township 17 Range 8W

Well No. #2 Andrews


Company Eldorado Ref.

NORTH

4

WEST

EAST

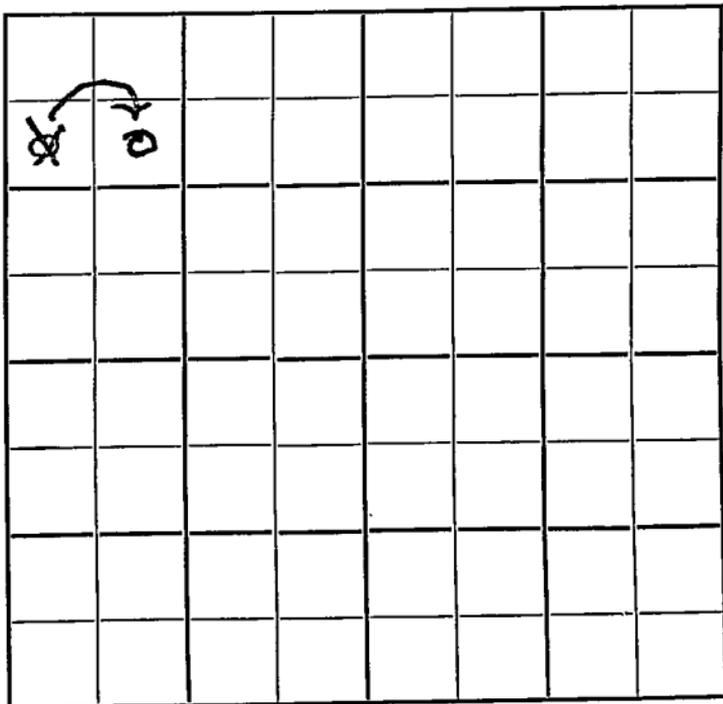

SOUTH

Ellsworth

KANSAS

Sec. 4 Twp. 17 R. 8W

Well No. #2 Andrews Farm

El Dorado Ref. Company

Sterling Drlg. Contractor


990 Ft. from N. Line

Ft. from S. Line

Ft. from E. Line

990
330 Ft. from W. Line

NW $\frac{1}{4}$ ~~SW NW NW~~
SE NW NW

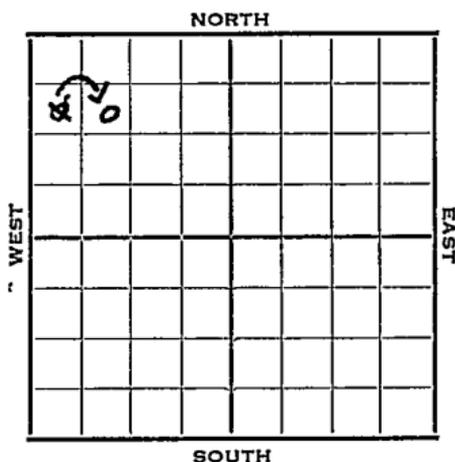

1952 Elev. 1688' REPORT

10/29 RUR
11/5 8" @ 318'
Heeb. 2622 Dodge 2642
Br Li 2747 Lans. 2774
Drlg. 2800'
11/12 Spu d 10-28-52
D&A
TD 3338'
8" @ 318
Heeb. 2622', Dodge 2642, Br.
lime 2747, Lans 2774', Cong
3127', Maq. 3157', Viola 3209',
Simp. 3250', Arb. 3313'
DST 3313-16, opn $\frac{1}{2}$ hrs., rec.
330' sw 975#
TD3338'
D&A

ABANDONED

County Ellsworth State Kansas

Sec. 4 (Blk. Twp.) 17 (Sur. Rge.) 8W Map No.

Operator Eldorado Ref.

Well No. 2 Farm Andrews

Elev. _____ Location SW NW NW

0							

990 Ft. From N Line NW

330 Ft. From W Line Quarter

Ist. Report OCT 29 1952

Completion _____

Remarks _____

Sterling Dr. Co. - Contr.

Spudding Date _____

Drig. Data _____

R U R

Map No. _____ Sec. 4 Twp. 17 R. 8W

Well No. 2 Andrews

Eldorado Ref. Company

CORRECTION Contractor

SE NW NW

SECTION PLAT

990 Ft. from N. Line

_____ Ft. from S. Line

_____ Ft. from E. Line

990 Ft. from W. Line

Ellsworth County

Location _____

Rig up _____

Drilling and Remarks: _____

Reported
SW NW NW

RECORD

Cased _____ in., _____ ft.

Sand _____

Gas _____

Oil _____

Total Depth _____

PRODUCTION:

1st 24 hrs. Nat. _____

1st 24 hrs. after shot _____

Gas _____ Cu. Ft.

Dry Hole _____

Abandoned _____

Date

NOV 5 1952 19

J. G. MCGHEE Scout

