


Section 4 Township 17 Range 8W

Well No. 1 Andrews "B"

Company El Dorado Ref.

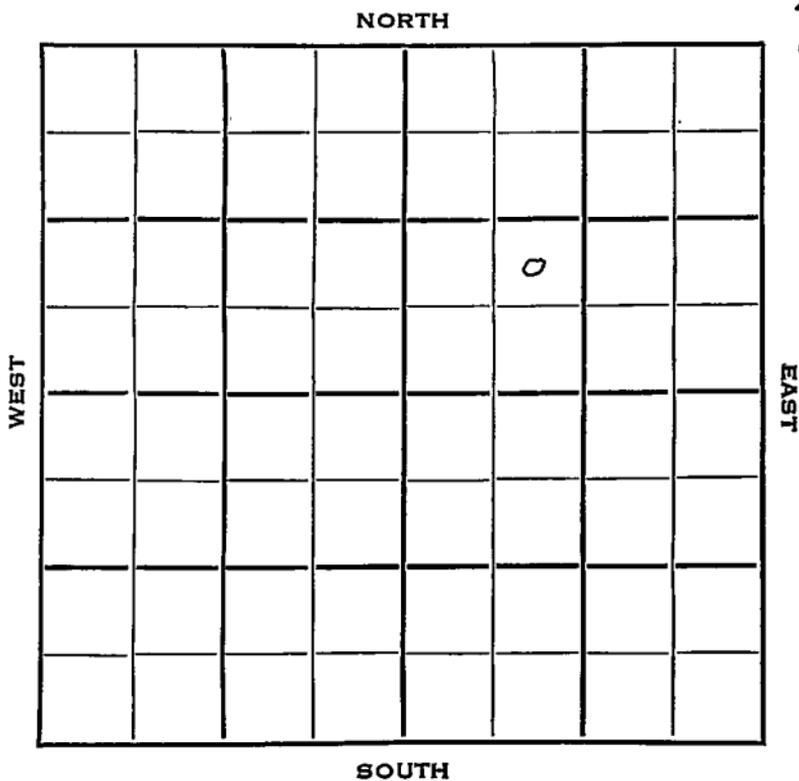

Ellsworth **KANSAS** ✓

Sec. 4 Twp. 17 R. 8W

Well No. 1 Andrews "B" Farm

Eldorado Ref. Company

Pickrell Drlg - Contr. Contractor

Semi Wildcat

_____ Ft. from N. Line

990


_____ Ft. from S. Line

_____ Ft. from E. Line

990

_____ Ft. from W. Line

NE SW NE

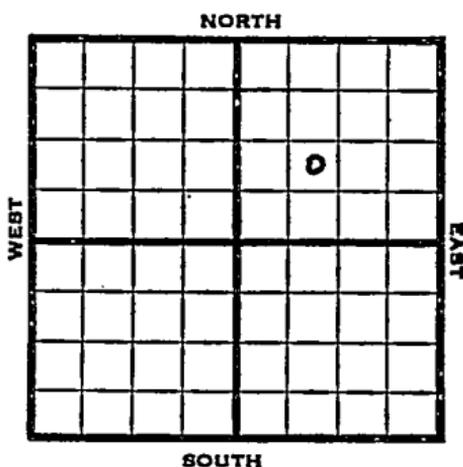


1953

Elev. 1685' REPORT

4/1 Location
 4/9 "
 4/16 8" @ 346
 Anhy 535
 Drlg. 2676'
 4/22 Spud 4-8-53 D & A TD 3298
 8" @ 346 Anhy 535 Heeb 2590
 Tor. 2609 Br lime 2709
 Lans. 2741 Maq. 3093
 DST 2747-2847 open 3/4 hr, rec 110'
 GCM, 1270' wtr.
 Viola 3182 Simp. 3232
 DST 3245-65 open 1 hr. rec 150' SW
 750# Arb. 3293
 DST 3294-98 open 1/2 hr. rec 360' OCW
 180' wtr. TD 3298
 D & A

ABANDONED

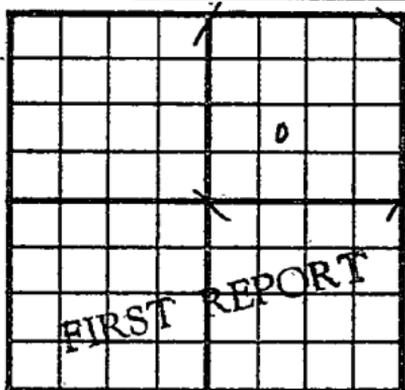County Ellsworth State KansasSec. 4 (Blk. Twp.) 17 (Sur. Rge.) 8W Map No.Operator Eldorado Ref.Well No. 1 Farm Andrews "B"Elev. _____ Location NE SW NE990 Ft. From S Line NE990 Ft. From W Line Quarter1st. Report APR 1 1953

Completion _____

Remarks _____

Pickrell Drlg. - Contr.

Spudding Date _____

Drlg. Data _____

Semi WildcatLocation

