


SECTION 4 TOWNSHIP 17 RANGE 8W

WELL NO. #1 Andrews "B"

COMPANY Rocket Drlg.

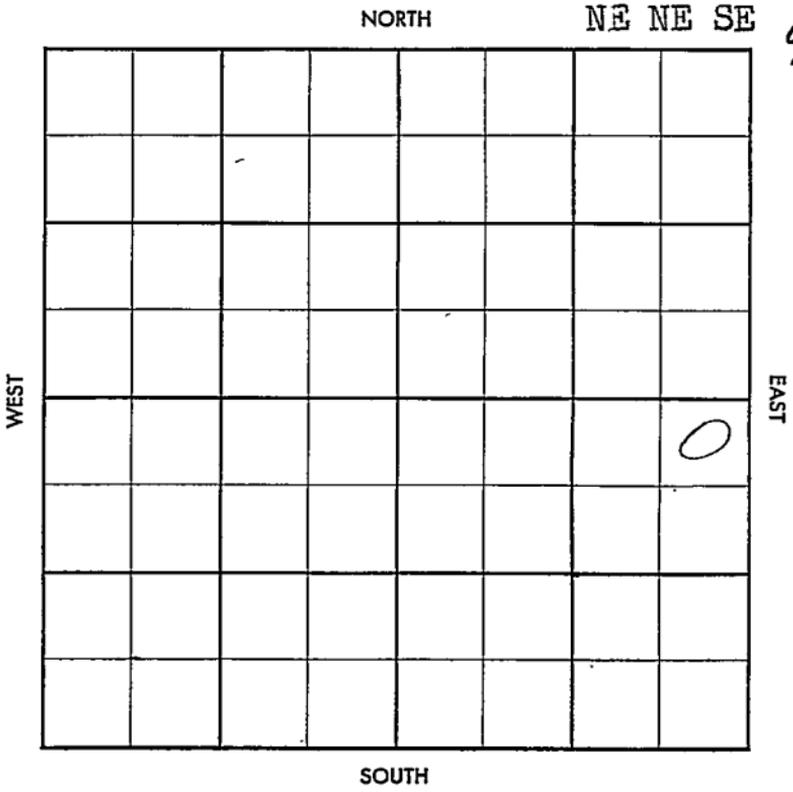

# WILDCAT

FORM 513 SUNRAY

County Ellsworth Elev. \_\_\_\_\_  
 Sec. 4 Twp. 17 Rgs. 8W  
 Company Rocket Drlg.  
 Farm Name Andrews "B" No. 1

TOPS	DEPTH	LOG	DATUM	Loc. in Sec.				
Anh.				NE NE SE				
Tr.								
H.								
Tr.								
Dg.								
Bl.								
L.				Geol. _____				
K.C.				Contr. _____				
B.K.C.				Co. Tools _____				
Ce.								
C.				Pool _____				
M.				Wildcat $\frac{1}{2}$ mile				
M.				<table border="1" style="width: 100%; height: 100%; border-collapse: collapse;"> <tr> <td style="text-align: center;">FIRST</td> <td style="text-align: center;">REPORT</td> </tr> <tr> <td style="text-align: center;">JUN 12 '57</td> <td style="text-align: center;">0</td> </tr> </table>	FIRST	REPORT	JUN 12 '57	0
FIRST	REPORT							
JUN 12 '57	0							
K.								
Mz.								
Ma.								
V.								
S.								
S.								
A.								
R.								
PE.								
G.								
T.B.								

Date Comm. \_\_\_\_\_  
 Location \_\_\_\_\_

~~12~~

County Ellsworth Elev. 1755  
 Sec. 4 Twp. 17 Rgs. 8W  
 Company Rocket Drly.  
 Farm Name Andrews "B" No. 1

TOPS	DEPTH	LOG	DATUM	Loc. in Sec.
Anb.				NE NE SE
Top				
H.				
Tr.				
Dg.				
Bl.	2777			
L.	2798			Geol.
K.C.				Contr.
B.K.C.	3116			Co. Tools
Ce.				Pool
C.				Wildcat 1/2 mi
M.				
M.				
K.				
Mz.				
Mo.				
V.	3246			<div style="border: 1px solid black; padding: 5px; text-align: center;"> <p><b>ABANDONED</b></p> <p>JUL 10 '57</p> </div>
S.	3290			
S. <i>sd</i>	3303			
A.	3353			
R.				
PE.				
G.				
T.D.	3360			

Date Comm.

Location JUN 19 '57 MIR

6-26-57 8578 290 1160  
DST 2786-2913 1hr 360' wtr  
BHP 1100/20" MD 2947 JUL 1 '57  
DST 3295-3328 1hr 130' GCWM  
FPO-90 BHP 400/20" DET  
3332-56 1hr 1440' sulpwtr BHP  
1050/20" DST 3356-60 1hr 45'  
WM + 2270' B/K sulpwtr no BHP  
D E Q