


Section 4 Township 17 Range 8 W

Well No. # 2 Andrews "B"

Company Elreco

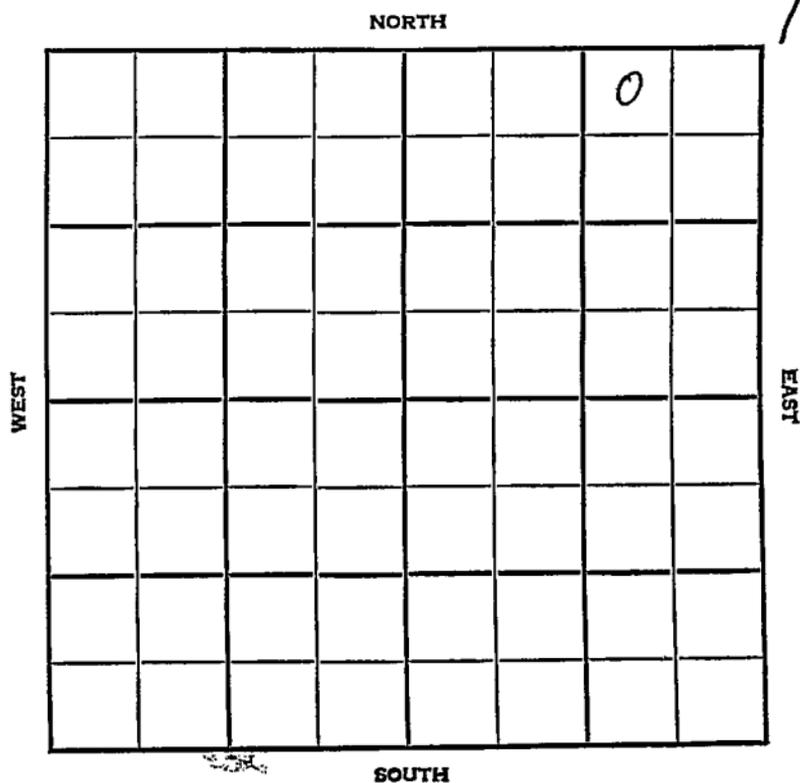

Ellsworth KANSAS

SEC. 4 TWP. 17 R. 8W ✓

WELL NO. 2 Andrews "B" FARM

COMPANY Elreco

CONTRACTOR Sterling Drlg.


Wildcat

330 Ft. from N. Line

Ft. from S. Line

990 Ft. from E. Line

Ft. from W. Line

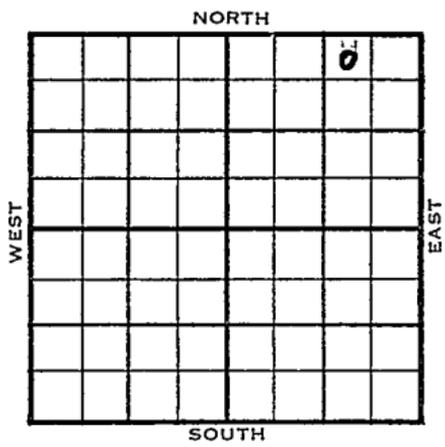

NW NE NE

1954 ELEVATION 1623' REPORT

5/19

Location

6/2

Spud 5-19-54  
 D&A  
 TD 3282'  
 8" @ 320'  
 Heeb 2541', Tor 2568', Br lime 2664',  
 Lans 2697', B KC ~~3008~~ 3008', Maq. 3045',  
 Viola 3161', Simp. 3205', Arb. 3265'  
 TD 3282'  
 D&A

ABANDONED

County **Ellsworth** State **Kansas**

Sec. **4** (Blk.) **17** (Sur.) **8W** (Twp.) **8W** Map No.

Operator **Elreco**

Well No. **2** Farm **Andrews "B"**

Elev. Location **NW NE NE**


**330** Ft. From **N** Line **NE**

**990** Ft. From **E** Line Quarter

1st. Report **MAY 19 1954**

Completion

Remarks

**Sterling Drlg. - Contr.**

Spudding Date

Drlg. Data **Wildcat**

**Location**

County Ellsworth State Kansas

Sec. 4 (Blk.) 17 (Sur.) 8W Map No.

Operator Elreco

Well No. 2 Farm Andrews "B"

Elev. 1623 Location NW NE NE

					0

330 Ft. From N Line NE

990 Ft. From E Line Quarter

Ist. Report

Completion JUN 2 1954

Remarks Wildcat

Sterling Drlg. - Contr.

Spudding Date 5-19-54

Drlg. Data D & A TD 3282

8" @ 320 Heeb. 2541 Tor. 2568

Br. lime 2664 Lans. 2697 B KC 3008

Maq. 3045 Viola 3161 Simp. 3205

Arb. 3265 TD 3282

D & A