

Map No. Sec. Twp. R.

Well No. Farm


..... Company

..... Ft. from N. Line

..... Ft. from S. Line

..... Ft. from E. Line

..... Ft. from W. Line

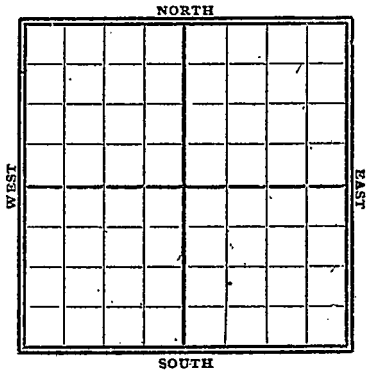

1927

Date

REPORT

Gypsy Records

12/3

Well TD 2500'

MAP No. _____ SEC. 4 TWP. 17S R. 8W

WELL No. #1 Hussey
J.R. Bryan COMPANY

CONTRACTOR _____

SECTION PLAT

no wall
 _____ FT. FROM N. LINE
 _____ FT. FROM S. LINE
 _____ FT. FROM E. LINE
 _____ FT. FROM W. LINE

RECORD

LOCATION _____
 RIG UP _____
 DRILLING AND REMARKS:

CASED _____ IN. _____ FT.
 SAND _____
 GAS _____
 OIL _____
 TOTAL DEPTH 7500'

PRODUCTION

1ST 24 HRS. NAT. _____
 1ST 24 HRS. AFTER SHOT _____
 GAS _____ ✓ _____ CU. FT.
 DRY HOLE _____ ✓
 ABANDONED _____

DATE

12/23 1927 _____ SCOUT