


Section 5 Township 17 Range 3-W

Well No. #2 Graslie

Company Texen

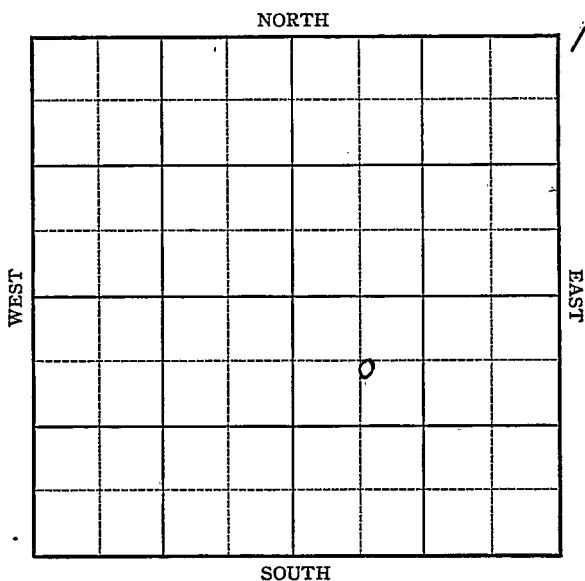

KANSAS

McPherson

Sec. 5 Twp. 17 R. 3-W

Well No. #2 Graslie Farm

Texon

Company


762 Ft. from N. Line

 Ft. from S. Line

 Ft. from E. Line

762 Ft. from W. Line

600.1336

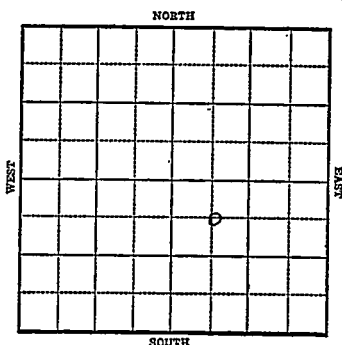

1943

R E P O R T

5/5 Location

5/12 Rotary

5/19 16" @ 202 WOC.

5/26 10" @ 340 WOC.

6/2 Drlg. 2646

6/9 Miss 2910
Viols 3388
Simp Sd 3466
T.D. 3471
Run 7"

6/16 7" @ 3463 Rust

6/23 54708 3477'
Swab 37 oil & 20 water in 13 hrs.

6/30 Viola 3388
Simp sd 3472
7" @ 3469'
Pump 365 oil plus 18 water Pot.
T.D. 3477'
Gravity 36

COMPLETED

KANSAS

McPherson

Map No. 42 Sec. 5 Twp. 17 R. 3WWell No. 2 GraslieTexon

Company

FIRST REPORT

Contractor

C NW SE

SECTION PLAT

		o	
			"

762 Ft. from N. Line

Ft. from S. Line

Ft. from E. Line

762 Ft. from W. Line

LINDSBORG POOL

Location XX

Rig up

Drilling and Remarks:

RECORD

Cased _____ in.; _____ ft.

Sand _____

Gas _____

Oil _____

Total Depth _____

PRODUCTION

1st 24 hrs. Nat. _____

1st 24 hrs. after shot _____

Gas _____ Cu. Ft.

Dry Hole _____

Abandoned _____

Date

MAY 5 1943 19 S. J. LEWIS Scout

KANSASMap No. 7 Sec. 5 Twp. 17 R. 3WWell No. 2 GraslieTexon

Company


COMPLETED

Contractor

C NW SE**SECTION PLAT**762 Ft. from N. Line

Ft. from S. Line

Ft. from E. Line

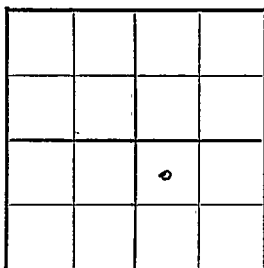762 Ft. from W. Line**LINDSBORG POOL**

Location _____

Rig up _____

Drilling and Remarks:

Viola 3388.
Comp Sol 3422
7" @ 3469
Pump 365 oil +
18W P. 8.

*(260 ft)***RECORD**

Cased _____ in., _____ ft.

Sand _____

Gas _____

Oil _____

Total Depth: 3422**PRODUCTION**

1st 24 hrs. Nat. _____

1st 24 hrs. after shot _____

Gas _____ Cu. Ft.

Dry Hole _____

Abandoned _____

Date

JUN 3 0 1943 19S. J. LEWIS Scout