

# KANSAS


McPherson

FORM 51 5M 1-42 PETROL

Section 5 Township 17 Range 3-W

Well No. #2 Hedguist

Company Mabee Oil

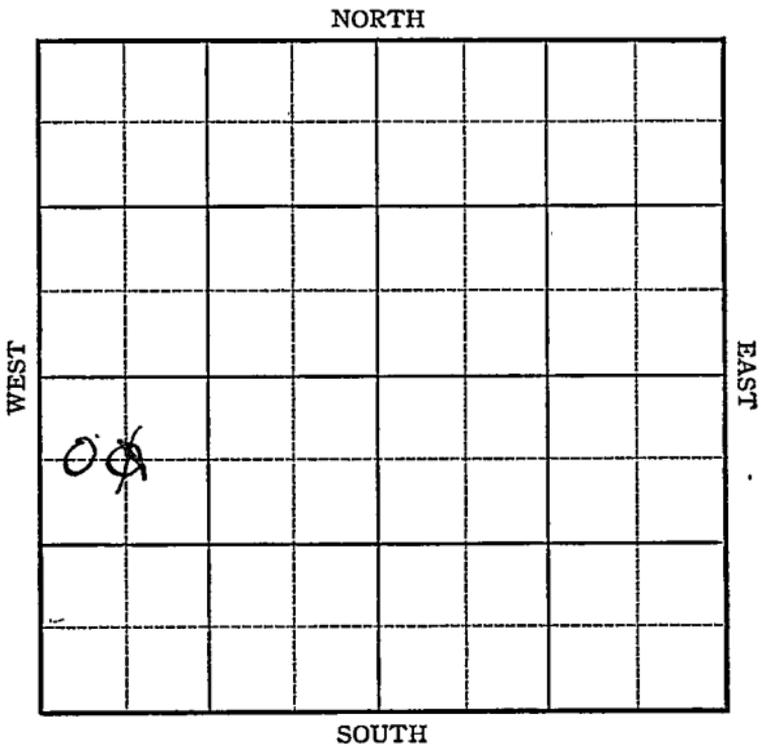

Sec. 5 Twp. 17 R. 3-W

Well No. #2 Hedguist Farm


Marbee Oil Company

660 Ft. from N. Line

         Ft. from S. Line

330 Ft. from E. Line

330 Ft. from W. Line

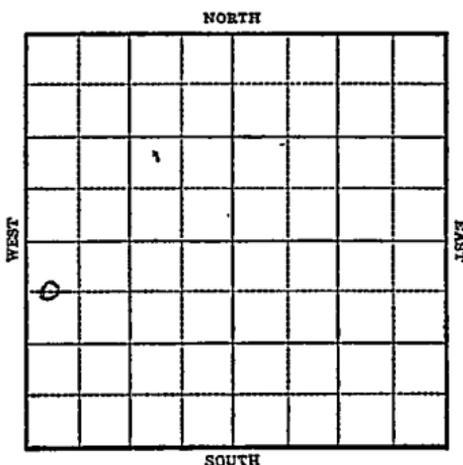

1943

R E P O R T

- 11/3 12" @ 155'  
W.O.C.
- 11/10 8" @ 332  
Drlg. 1930'
- 11/17 Viola 3359-60  
TD 5" @ 3359  
RUST
- 11/24 TD 3365  
1500 Acid
- 12/1 TD 3366  
2300' oil
- 12/8 5" @ 3359  
Viola 3359  
PB 3364  
1500 acid  
Pump 91 Pot.  
T.D. 3366  
Gravity 36

**COMPLETED**

KANSAS

Map No. 42 Sec. 5 Twp. 17 R. 3W

Well No. 2 Hedguist

Mabee Oil Company

FIRST REPORT Contractor

C W E NW SW

660 Ft. from N. Line

\_\_\_\_\_ Ft. from S. Line

\_\_\_\_\_ Ft. from E. Line

330 Ft. from W. Line

SECTION PLAT


Lindsborg Pool

Location \_\_\_\_\_

Rig up \_\_\_\_\_

Drilling and Remarks:

12"-155 WOC

RECORD

Cased \_\_\_\_\_ in., \_\_\_\_\_ ft.

Sand \_\_\_\_\_

Gas \_\_\_\_\_

Oil \_\_\_\_\_

Total Depth \_\_\_\_\_

PRODUCTION

1st 24 hrs. Nat. \_\_\_\_\_

1st 24 hrs. after shot \_\_\_\_\_

Gas \_\_\_\_\_ Cu. Ft.

Dry Hole \_\_\_\_\_

Abandoned \_\_\_\_\_

Date

NOV 3 1943 19

S. J. LEWIS Scout

KANSAS

Map No. 42 Sec. 5 Twp. 17 R. 3W

Well No. 2 Hedguist

Mabee Oil Company

COMPLETED Contractor

C W L NW SW

SECTION PLAT

660 Ft. from N. Line

\_\_\_\_\_ Ft. from S. Line

\_\_\_\_\_ Ft. from E. Line

330 Ft. from W. Line

0			

Lindsborg Oil

Location \_\_\_\_\_

Rig up \_\_\_\_\_

Drilling and Remarks:

*Viola 3359*  
*5 @ 3359.*  
*PA 3364 1500 acid*  
*Pump 9/10 J.*

*360 Gr*

RECORD

Cased \_\_\_\_\_ in., \_\_\_\_\_ ft.

Sand \_\_\_\_\_

Gas \_\_\_\_\_

Oil \_\_\_\_\_

Total Depth 3366

PRODUCTION

1st 24 hrs. Nat. \_\_\_\_\_

1st 24 hrs. after shot \_\_\_\_\_

Gas \_\_\_\_\_ Cu. Ft.

Dry Hole \_\_\_\_\_

Abandoned \_\_\_\_\_

Date

DEC 8 1943 19

S. J. LEWIS Scout