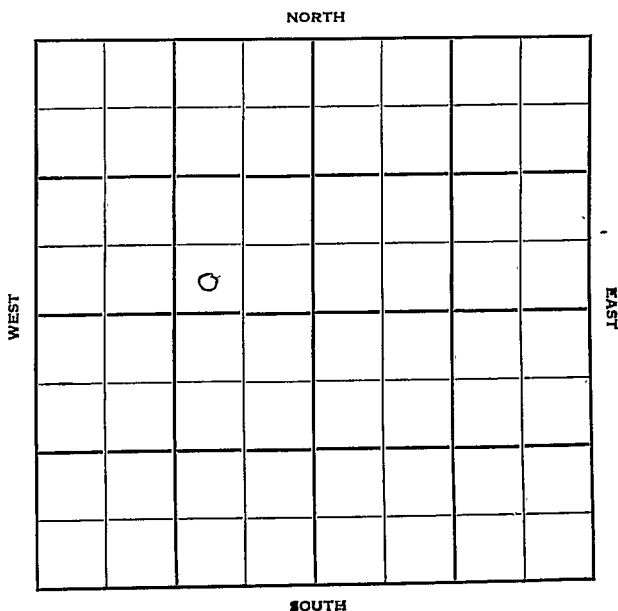


Section 5 Township 17 Range 3WWell No. #1 FernCompany Musgrove Pet.

McPherson

Sec. 5 Twp. 17 R. KANSAS 3W

Well No. #1 Fern Farm

Musgrove Pet. Company

Musgrove Pet. - Contr. Contractor


 Ft. from N. Line

330' Ft. from S. Line


990' Ft. from E. Line

 Ft. from W. Line

SW SE NW

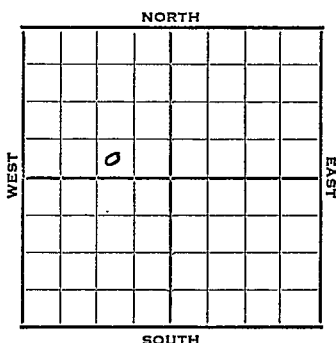

1952	Elev. 1340' REPORT
4/16	Cellar & pits
4/23	"
4/30	"
5/7	"
5/14	8" @ 370 Drlg. 2298'
5/21	Miss 2925' V. 3357'
	DST 3358-62' RTD 1 hr. 15' HOCM
	550# 4" @ 3357' WOC
5/28	Spud 5-7-52
	D & A TD 3363' 8" @ 370
	Miss 2925' Viola 3357'
	DST 3358-62 open 1 hr. rec 15' HOCM
	4" @ 3357 TD 3363 Hydro
	S/1 BOPH 6 BW
	D & A
	ABANDONED

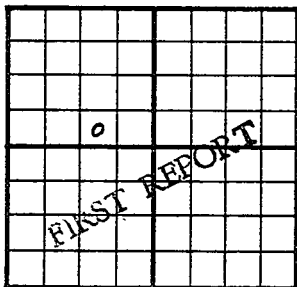County McPherson State KansasSec. 5 (Blk.) 17 (Sur.) SW Map No.Operator Musgrove Pet.Well No. 1 Farm FernElev. _____ Location SW SE NW330 Ft. From S Line NW990 Ft. From E Line Quarter1st. Report APR 1 6 1952

Completion _____

Remarks _____

Musgrove - Contr.

Spudding Date _____

Drilg. Data _____

Cellar & pits

J. G. McGEHEE