


Section 5 Township 17 Range 4W

Well No. #1 Lundquist

Company E. E. Carey

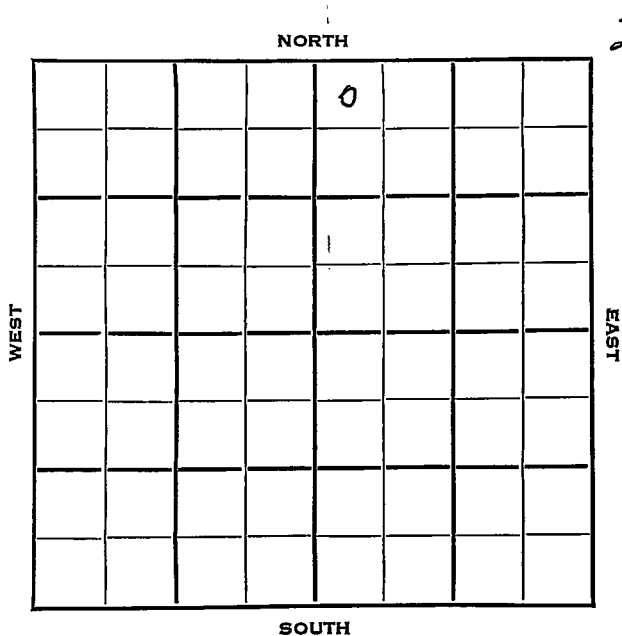

McPherson KANSAS

SEC.	5	TWP.	17	R.	4W ✓
------	---	------	----	----	------

WELL NO.

1 Lundquist

FARM

COMPANY

E. K. Carey

CONTRACTOR

Carey

Wildcat

330


Ft. from N. Line

Ft. from S. Line

Ft. from E. Line

330

Ft. from W. Line

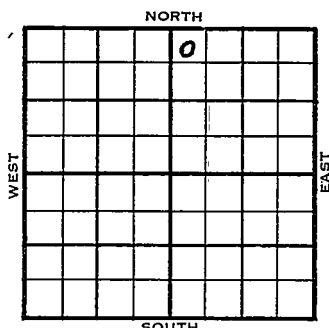

NW NW NE

Continental Farmout

1953

ELEVATION

1517'

REPORT

12/16

Spud 12-10-53

8" @ 678'

Drlg. 1525'

12/30

Spud 12-10-53

D & A

TD 3895'

8" @ 678'

Anhy 642', Lans 2534', Miss 3224',

B. Miss 3466' Maq 3686,

DST 3687'-94' opn 1 hr, rec 5' Mud

935# Viola 3726'; Simp sh 3813'

Simp. dol. 3816', Simp sd. 3832'

DST 3820'-37' opn 2 hr, rec 62' smcw

1115# Arb 3877'

TD 3895'

D & A

ABANDONED

County McPherson State Kansas
 Sec. 5 (Blk.) 17 (Sur.) 4W Map No. _____
 Operator E. K. Carey
 Well No. 1 Farm Lundquist
 Elev. _____ Location NW NE NE


FIRST REPORT

330 Ft. From N Line NE
330 Ft. From W Line Quarter
 Ist. Report DEC 16 1953
 Completion _____
 Remarks Continental farmout
Carey - Contr.
 Spudding Date 12-10-53

Drilg. Data Wildcat
8" @ 678 drilg. 1525

J. G. McGEHEE

County McPherson State Kansas
 Sec. 5 (Blk. 17 (Sur. 4W Map No.
 (Twp.) (Rge.)
 Operator E. K. Carey
 Well No. 1 Farm Lundquist
 Elev. 1547 Location NW NW NE

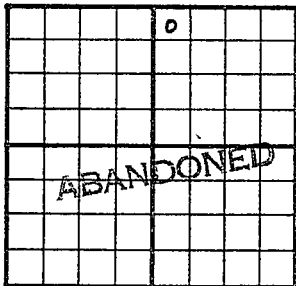

330 Ft. From N Line NE
330 Ft. From W Line Quarter
 Ist. Report
 Completion DEC 30 1953
 Remarks Wildcat
Carey - Contr.
 Spudding Date 12-10-53

Drlg. Data D & A TD 3895
8" @ 678 Anhy 642 Lans. 2534
Miss. 3224 B. Miss. 3466 Maq. 3686
DST 3687-94 open 1 hr. Rec. 5' mud
935# Viola 3726 Simp. sh. 3813
Simp. dol. 3816 Simp. sd. 3832
DST 3820-37 open 2 hr. Rec. 62' smcw
1115# Arb. 3877 TD 3895

D & A

J. G. McGEHEE