


McPherson **KANSAS**

Section 5 Township 17 Range 3W

Well No. #2 Sand

Company Kernfeld

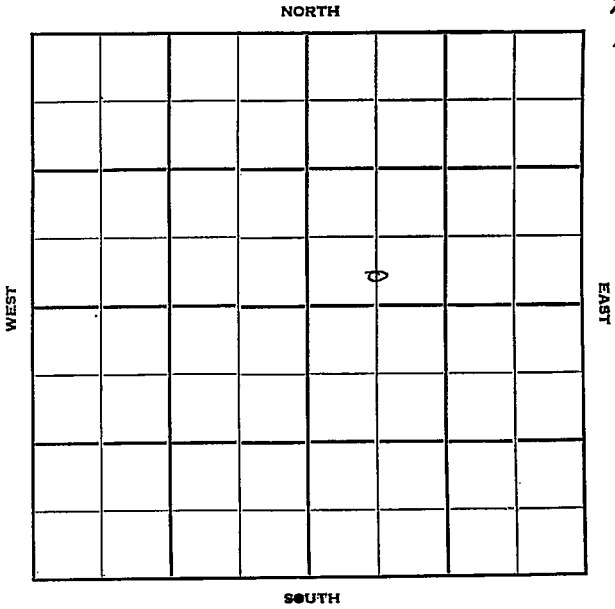

McPherson

KANSAS

Sec. 5 Twp. 17 R. 3W

Well No. #2 Sand Farm

Kornfeld Company

Sterling Drlg. - Contr. Contractor

Lindsborg Pool


_____ Ft. from N. Line

330' Ft. from S. Line

_____ Ft. from E. Line

660' Ft. from W. Line

C S L SW NE

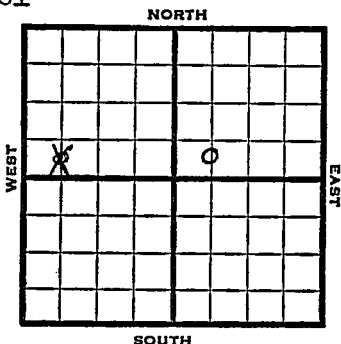

1950 Elev 1334' REPORT

1/26 8" @ 355'
12-3/4" @ 161
Drlg. 550'

1951
1/17 8" @ 355'
12 3/4" @ 161
Miss 3105 Maq 3334
Viola 3389 Simp 3455
Sand 3473
DST 3459-77 opn 1 hr rec 45' socm
5" @ 3472
21/3469-73
TD 3481
SSO & Water SP 3478
Perf 3472-78 test water
27/3380-89 water
30/3330-31 water
TD 3481'
D&A

ABANDONED

County McPherson State Kansas

Sec. 5 (^{Blk.}) (^{Twp.}17) (^{Sur.}3W) (^{Rge.}) Map No.

Operator Kornfeld

Well No. 2 Farm Sand

Elev. Location C S L SW NE

330 Ft. From S Line NE

660 Ft. From W Line Quarter

1st. Report DEC 6 1950

Completion

Remarks

Sterling Drlg. - Contr.

Spudding Date

Drlg. Data Lindsborg Pool

8" @ 355 12 3/4" @ 161 drlg. 550

County McPherson State Kansas

Sec. 5 (Blk.) 17 (Sur.) 3W Map No.

Operator Kornfeld

Well No. 2 Farm Sand

Elev. 1334 Location C S L SW NE

330 Ft. From S Line NE

660 Ft. From W Line Quarter

1st-Report

Completion JAN 17 1951

Remarks Lindsborg Pool

Sterling Drlg. - Contr.

Spudding Date

Drlg. Data D & A TD 3481

8" @ 355 12 3/4" @ 161 Miss. 3105

Maq. 3334 Viola 3389 Simp. 3455

Sand 3473 DST 3459-77 open 1 hr.

Rec. 45' socm 5" @ 3472 21/ 3469-73

TD 3481 SSO & water SP 3478 Perf. 3472-

78 test water 27/ 3380-89 water

30/ 3330-31 water

D & A