

KANSAS


McPherson

FORM 51 5M 1-42 PETROL

Section 5 Township 17 Range 3-W

Well No. #2 Rundebach

Company Carter

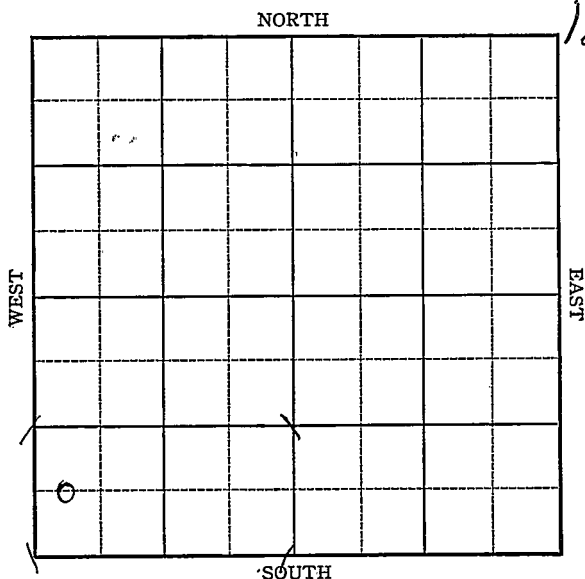

KANSAS

McPherson

Sec. 5 Twp. 17 R. 3-WWell No. #2 Rundebeck FarmCarter Oil Company

Lindsborg


Ft. from N. Line

669 Ft. from S. Line

Ft. from E. Line

330 Ft. from W. Line

Cw1 SW SW

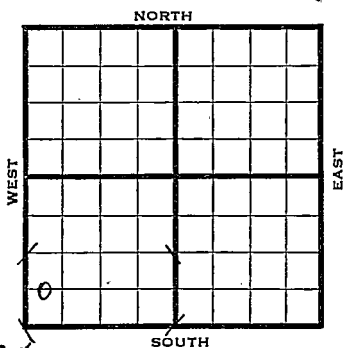EE. 1340

1943

REPORT

1/27 Rotary.
2/3 8" @ 335' WOC
2/10 Drlg. 1960'
2/17 Miss 2910
Drlg. 3033
2/24 Viola 3349
TD 3351 SO
5" Casing set 3349 RUST.
3/3 TD 3355, 2500 acid
Swab 8bbbls oil per hr.
3/10 " " " " "
3/16 " " " " "
3/24 " " " " "
3/31 Viola 3349
5" @ 3349
2500 acid
Pump 171 oil & 27 water.
Gr. 36
T. D. 3355'

COMPLETED

KANSAS
 Map No. Sec. 5 Twp. 17 R. 3W

Well No. 2 Rundbeck

Carter Company

FIRST REPORT Contractor

C WL SW SW


 Ft. from N. Line

660 Ft. from S. Line

 Ft. from E. Line

330 Ft. from W. Line

SECTION PLAT

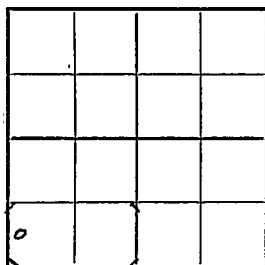

LINDSBORG POOL

Location

Rig up

Drilling and Remarks:

Rotary

RECORD

Cased in., ft.

Sand

Gas

Oil

Total Depth

PRODUCTION

1st 24 hrs. Nat.

1st 24 hrs. after shot

Gas Cu. Ft.

Dry Hole

Abandoned

Date

JAN 27 1943 19 S. J. LEWIS Scout

McPherson

KANSAS

Map No. 42 Sec. 5 Twp. 17 R. 3WWell No. 2 Runderbeck

Carter

Company

COMPLETED

Contractor

C WL SW SW

SECTION PLAT

Ft. from N. Line

660 Ft. from S. Line

Ft. from E. Line

330 Ft. from W. Line

LINDSBORG POOL

Location

Rig up

Drilling and Remarks:

*Vidla 3348**5" @ 3348**2500 acid**Pump 121 oil + 22**Water**362 gr*

RECORD

Cased _____ in., _____ ft.

Sand _____

Gas _____

Oil _____

Total Depth 3355

PRODUCTION

1st 24 hrs. Nat. _____

1st 24 hrs. after shot _____

Gas _____ Cu. Ft.

Dry Hole _____

Abandoned _____

Date

MAR 3 1 1943

19

S. J. LEWIS Scout