

KANSAS


McPherson County

FORM 51 5M PETROL

Section 5 Township 17 Range 3W

Well No. 1 Sand

Company Kornfeld etal

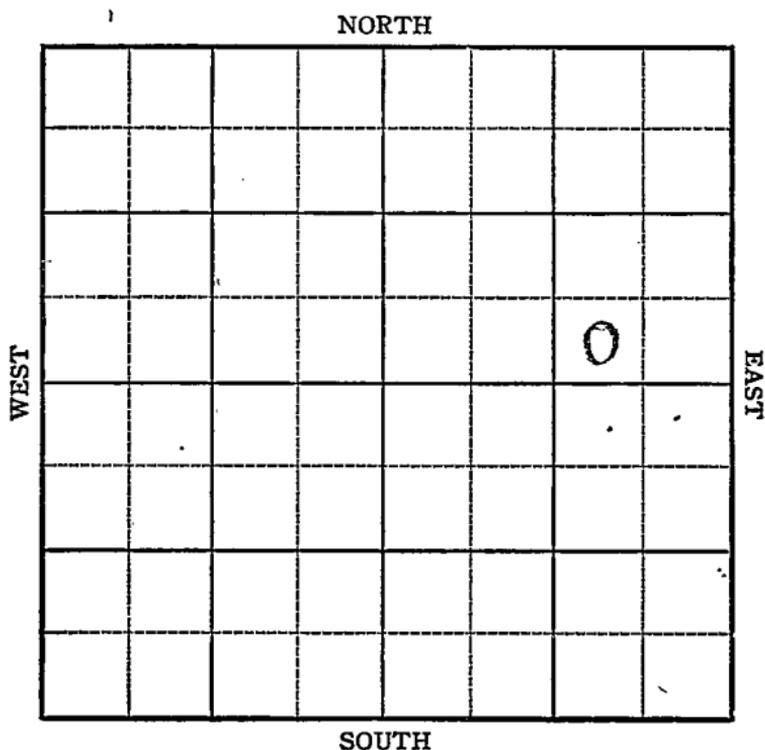

KANSAS

McPherson

Sec. 5 Twp. 17 R. 3W

Well No. 1 Sand Farm _____
Kornfield etal Company _____


Lindsborg

_____ Ft. from N. Line

330 Ft. from S. Line

990 Ft. from E. Line

_____ Ft. from W. Line

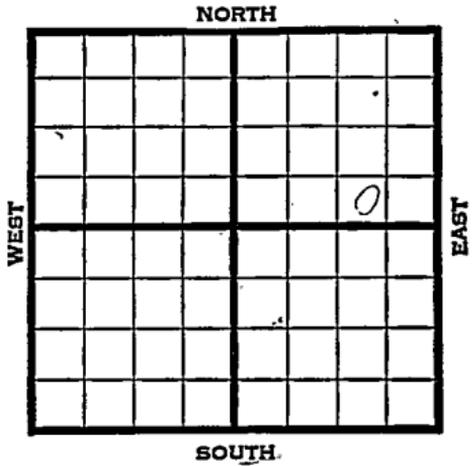

SW 34 35 36

1945 Elev. 1332 REPORT

- 6/6 12^m -188
250'
- ~~6/14~~
6/21 8" @ 346 Drlg. 1890
Miss 2870
Drlg. 3075
- 6/28 Miss 2907 corrected
B Miss 3103
Viola 3387
Simp Sds 3472-74 TD
5" @ 3470 RUST
- 7/11 Simp Sd 3472
5" @ 3470
TD 3477'

ABANDONED


KansaPool Name LindsborgMap No. 42 Sec. 5 Twp. 17 R. 3WWell No. 1 SandKornfeld etal Company

FIRST REPORT

Contractor

SW SE NE

SECTION PLAT

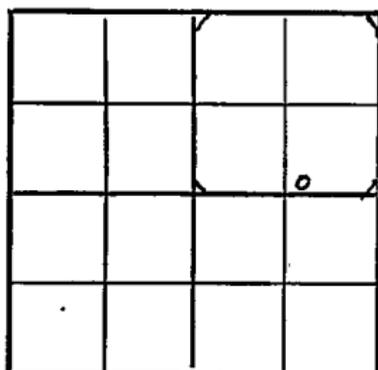 Ft. from N. Line330 Ft. from S. Line990 Ft. from E. Line Ft. from W. Line

McPherson County

Location Rig up

Drilling and Remarks:

12" - 188
250'

RECORD

Cased in., ft.Sand Gas Oil Total Depth

PRODUCTION

1st 24 hrs. Nat. 1st 24 hrs. after shot Gas Cu. Ft.Dry Hole Abandoned

Date


JUN 6 1945 19

S. J. LEWIS

Scout

KANSAS Kansas Pool Name LindsborgMap No. 42 Sec. 5 Twp. 17 R. 3WWell No. 1 SandKornfeld etal CompanyABANDONED Contractor

SW SE NE

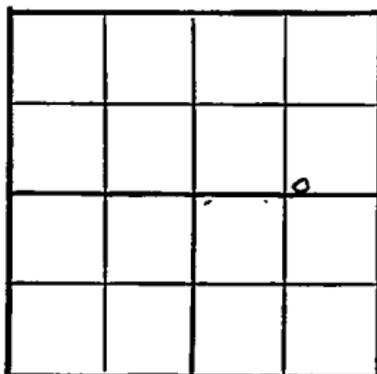E1132
SECTION PLAT Ft. from N. Line330 Ft. from S. Line990 Ft. from E. Line Ft. from W. LineMcPherson County

RECORD

Location Cased in., ft.Rig up Sand

Drilling and Remarks:

Gas Oil Total Depth 3477

PRODUCTION

1st 24 hrs. Nat. 1st 24 hrs. after shot Gas Cu. Ft.Dry Hole Abandoned

Date

JUL 1 1 1945 19S. J. LEWIS Scout