


Section 5 Township 17 Range 8 W

Well No. # 2 Hodgson

Company Continental Oil

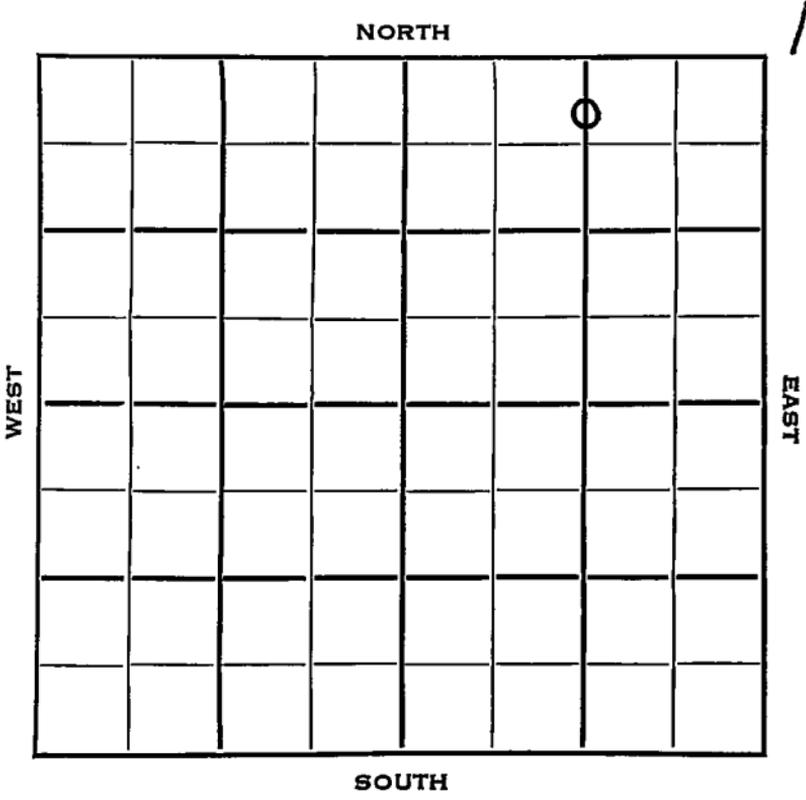

Ellsworth KANSAS ✓

5

17

8W

Sec. _____ Twp. _____ R. _____

#2 Hödgson

Well No. _____ Farm _____

Continental Oil

Company _____

Lohman & Johnson

Contractor _____

440

Ft. from N. Line


Ft. from S. Line

1320

Ft. from E. Line

Ft. from W. Line

C N $\frac{1}{2}$ N $\frac{1}{2}$ NE

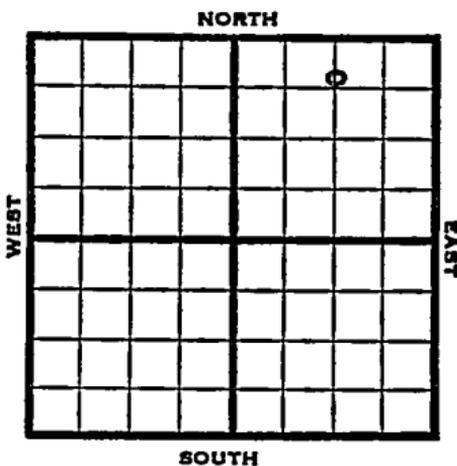

1953

Elev. 1700' REPORT

4/15

Spud 4-10-53
10-3/4" @ 306
Drlg. 1338'

4/23

Schl tops: Br li 2747' Lans 2766
B KC 3120 V 3248 Simp 3309
Arb. 3362 RTD 3395'

4/30

NR

5/7

"

5/21

NR

5/28

"

6/3

Spud 4-10-53 D & A TD 3395
10-3/4" @ 306 Br lime 2747 Lans
2766 B KC 3120 Viola 3248
Simp 3309' Arb. 3362 TD 3395
D & A

ABANDONED

