

Section 6 Township 17 Range 9-W

Well No. #1, Melchert

Company Alyward Prod.

NORTH

SOUTH

WEST

EAST

0

12

KANSAS


Ellsworth County ✓

Sec. 6 Twp. 17 R. 9WWell No. #1 Melchert FarmAylward Prod. Company

Stolenberg

990 Ft. from N. Line Ft. from S. Line Ft. from E. Line330 Ft. from W. Line

SW NW SW

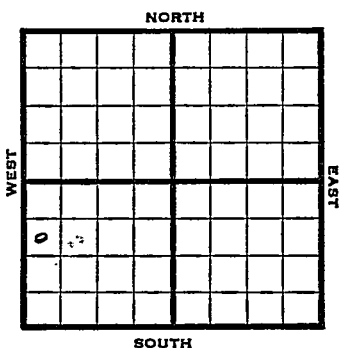

1946

1803

REPORT

9/18 RUR

9/24 "

10/1 8" @ 227
Drlg 2500'10/9 Lans 2929'
Arb 3294'
TD 3299'

ABANDONED

KANSAS

Pool Name StolenbergMap No. 42 Sec. 6 Twp. 17 R. 9WWell No. 1 Melchert

Aylward Prod.

Company

FIRST REPORT

Contractor


SW NW SW

SECTION PLAT

990 Ft. from N. Line

Ft. from S. Line

Ft. from E. Line

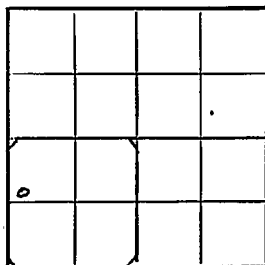330 Ft. from W. LineEllsworth County

Location

Rig up

Drilling and Remarks:

R U R

RECORD

Cased _____ in., _____ ft.

Sand _____

Gas _____

Oil _____

Total Depth _____

PRODUCTION

1st 24 hrs. Nat. _____

1st 24 hrs. after shot _____

Gas _____ Cu. Ft.

Dry Hole _____

Abandoned _____

Date

SEP 1 8 1946

19

S. J. LEWIS

Scout

KANSAS

Form 26 200 Bks. 10-46 Petrol **Kansas**

Stoltenberg Pool

Map No. 45 Sec. 6 Twp. 17 R. 9W

Well No. 1 Melchert

Aylward Prod. Company

ABANDONED

Contractor

SW NW SW


E. 1/8
SECTION PLAT

990 Ft. from N. Line

 Ft. from S. Line

 Ft. from E. Line

330 Ft. from W. Line

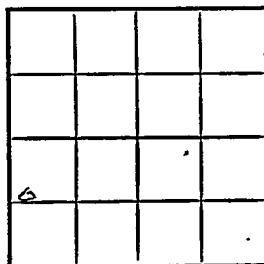

Ellsworth County

Location

Rig up

Drilling and Remarks:

Ham 2829
CR 28294

RECORD

Cased in., ft.

Sand

Gas

Oil

Total Depth 3299

PRODUCTION

1st 24 hrs. Nat.

1st 24 hrs. after shot

Gas Cu. Ft.

Dry Hole

Abandoned

Date

OCT 9 1946 19

S. J. LEWIS Scout