

Ellsworth


Form 51-5M-2-29-34703

Map No. **KANSAS** Sec. 6 Twp. 17 R. 9w

Well No. 1- Melchert Farm

Shelly Oil Co Company

NORTH

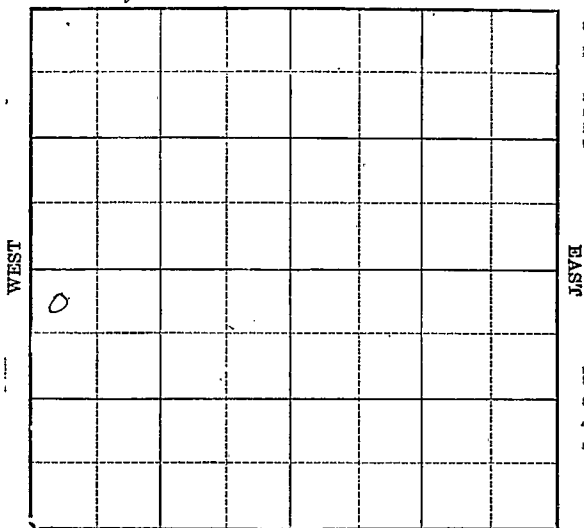

SOUTH

Location

Drilling Remarks

Rig Up

Drilling Remarks

RECORD

Cased _____ in. _____ ft.

Sand _____

Gas _____

Oil _____

Total Depth _____

PRODUCTION

1st 24 hrs. Nat. _____

1st 24 hrs. after shot _____

Gas _____ cu. ft.

Dry Hole _____

Abandoned _____


Map No. **KANSAS** Sec. 6 Twp. 17 R. 9th
Well No. 1-Melchert Farm
Shelly Oil Company

330 Ft. from N. Line

_____ Ft. from S. Line

_____ Ft. from E. Line

330 Ft. from W. Line

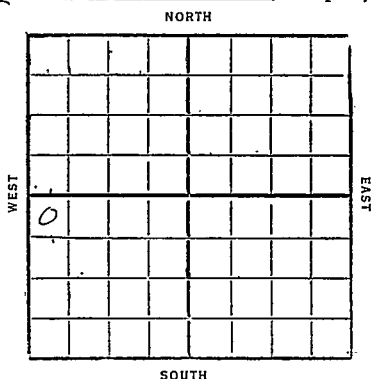

1932

Date	REPORT
5/26	Loc
6/1	Bldg rig
6/8	Spdg 60'
6/15	20"-65'
	Dreg 270'
6/22	" 825'
6/29	" 1765'
7/6	" 2252'
7/13	10"-1850
	Dreg 2815
7/20	show oil 3045
	8"-3048
	TD 3080 UIR 8"
7/27	Dreg 3181
8/3	Top Cong 3236
	16" 3290
	Top Chic line 3290
	Pay 3293-94
	500' oil & 1 barrel water
	for hour
	HFW 3295-98
	Well P.B. and shoot

8/10- T.D. 3298

P.B. to 3294 1/2

Shot 10 qt 3290-94 1/2

Made 6 bbl oil and
10 bbl water 24 hr

8/17- 1 Cased 6"-3290

Electric line 3290-98

Pay 3293-94

500 ft oil & 1 barrel water

HFW 3295-98

T.D. 3298

P.B. to 3294 1/2

Shot 10 qt 3290-94 1/2

Made 6 bbl oil and
10 bbl water 24 hr

Abandoned

45 KANSAS

Ellsworth

Map No. _____ Sec. 6 Twp. 17 R. 9 W

Well No. 1 Melcher

Stelly Oil Co Company

Contractor

FIRST REPORTS

330 Ft. from N. Line

Ft. from S. Line

Ft. from E. Line

330 Ft. from W. Line

SECTION PLAT

Location ✓

Rig up

Drilling and Remarks:

RECORD

Cased _____ in., _____ ft.

Sand _____

Gas _____

Oil _____

Total Depth _____

PRODUCTION

1st 24 hrs. Nat. _____

1st 24 hrs. after shot _____

Gas _____ Cu. Ft.

Dry Hole _____

Abandoned _____

Date

MAY 25 1932 CHAS. L. SHERWOOD

192

Scout

Ellsworth

#5 KANSAS

Map No. _____ Sec. 6 Twp. 17 R. 9 W

Well No. 1 Melcher

Kelley Oil Co. Company

Contractor

COMPLETED

SECTION PLAT

330 Ft. from N. Line

_____ Ft. from S. Line

_____ Ft. from E. Line

330 Ft. from W. Line

ABANDONED

Location _____

Rig up _____

Drilling and Remarks:

Pay 3293-94
 500. Oil & 1 BW.
 HKW 3295-98
 PB 70 3294 1/2
 10/ 3290-94 1/2
 6 Bbls Oil & 10 Bbls Water
 24 Hours. D & A.

RECORD

Cased 6 in., 3290 ft.

Sand Sil. 3290-98

Gas _____

Oil _____

Total Depth 3298

PRODUCTION

1st 24 hrs. Nat. _____

1st 24 hrs. after shot _____

Gas _____ Cu. Ft.

Dry-Hole _____ ✓

Abandoned _____ ✓

Date

AUG 17 1932

CHAS. L. SHERWOOD

192

Scout