


Section 6 Township 17 Range 3-W


Well No. #1 Berglund

Company J. E. Mabee

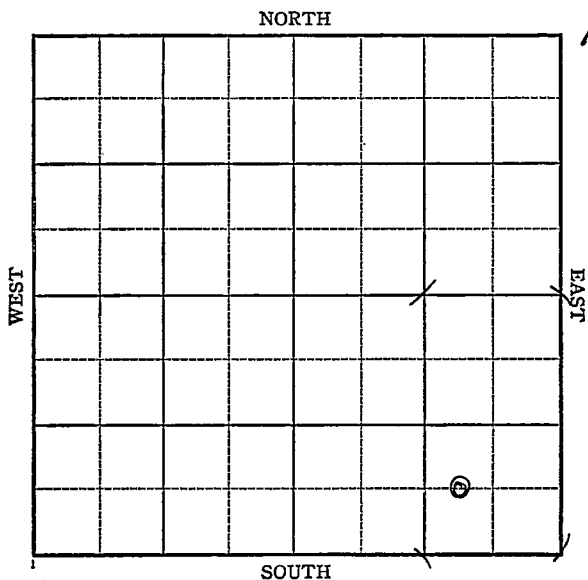

Sec. 6 Twp. 17 R. 3-WWell No. #1 Berglund FarmJ. E. Mabee Company

(Lindsborg)

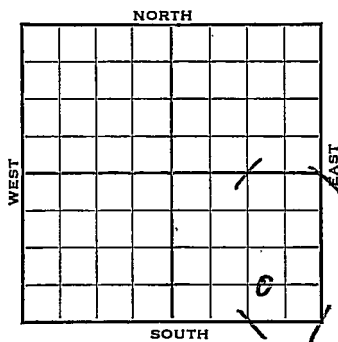 Ft. from N. Line660 Ft. from S. Line990 Ft. from E. Line Ft. from W. Line


1942	REPORT			
7/15	8" - 335'			
	Drlg. 548'			
7/22	Drlg. 2543'			
7/29	Viola 3355-56 T.D. Run 5"			
8/5	5" - 3355	T.D. 3364		
	1000 acid			
	pump 80 oil in 6 hrs.			
8/12	" " "	"		
8/19	TD 3366'	Pump 7 oil per hr 6 hrs		
8/27	"	"	"	
9/2	"	"	"	
9/9	"	"	"	
9/16	"	"	"	
9/23	Pump 15 ¹ / ₂ oil 2% water.			
9/30	Viola 3355			
	5" 3355			
	TD 3366			
	1000 acid			
	Phy. pot. 49 bopd slight show wtr.			
	36 grav.			
COMPLETED				

McPherson KANSAS

Map No. 42 Sec. 6 Twp. 17 R. 3WWell No. 1 BerglundJ. E. Mabee CompanyFIRST REPORT Contractor

C WL SE SE

SECTION PLAT

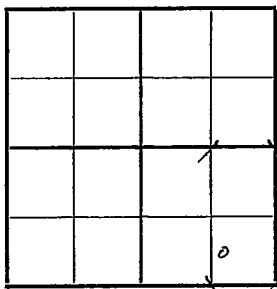 Ft. from N. Line660 Ft. from S. Line990 Ft. from E. Line Ft. from W. Line

LINDSBORG POOL

Location Rig up

Drilling and Remarks:

8" - 335'

Drlg. 548'

RECORD

Cased in., ft.Sand Gas Oil Total Depth


PRODUCTION

1st 24 hrs. Nat. 1st 24 hrs. after shot Gas Cu. Ft.Dry Hole Abandoned

Date

JUL 15 1942 19

S. J. LEWIS Scout

 

Q. 18 18 18
Q. 18 18 18
Q. 18 18 18
Q. 18 18 18

FOR DLR

Misc. Small Maps	
Cards	
Tracing	
France Map	
Scarborough Map	
Moody Map	
Geological Dept.	
Moody Flat Book	

2/2/21

McPherson

Map No. 42 Sec. 6 Twp. 17 R. 3W

Well No. 1 Berglund

J. E. Mabree Company

Contractor

C WL SE' SE

SECTION PLAT

_____ Ft. from N. Line

660 Ft. from S. Line

990 Ft. from E. Line

Ft. from W. Line

			0

LINDSBORG POOL

Location_____

Rig up_____

Drilling and Remarks:

1000 Acid
Phy. Pot
49 Bopd
slight show Wtr
36 grav

RECORD

Cased 5 in., 3355 ft.

Sand _____

Gas _____

Oil _____

Total Depth 3366

PRODUCTION

1st 24^{hrs.} Nat. _____

1st 24 hrs. after shot_____

Gas_____ Cu. Ft.

Dry Hole_____

Abandoned_____

Date _____

COMPLETED

SEP 3 0 1942 19

S. J. LEWIS Scout

Viola 3355

Misc. Small Maps	✓
Cards	✓
Tracing	✓
France Map	✓
Scarborough Map	✓
Moody Map	✓
Geological Dept.	
Moody Flat Book	