KANSAS


FORM 51 5M 4-41 PETROL

McPherson

Section 6 Township 17 Range 3-W

Well No. #1 Carlson

Company J. E. Mabee

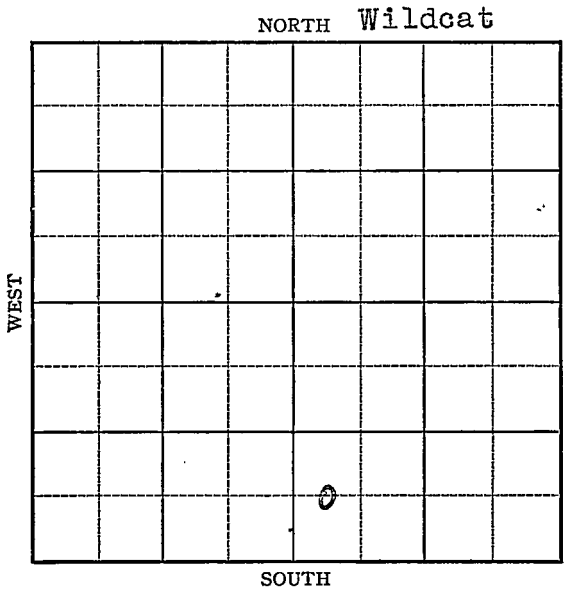

FORM 252-A
5M 10-41 PETROL

KANSAS

McPherson

Sec. 6 Twp. 17 R. 3-W

Well No. #1 Carlson Farm

J. E. Mabee Company

(Wildcat)


_____ Ft. from N. Line

660 Ft. from S. Line

_____ Ft. from E. Line

330 Ft. from W. Line

Elev. 1353

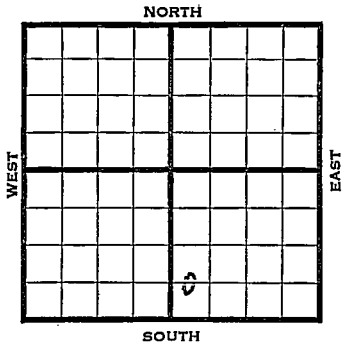

1942	REPORT
6/10	Derrick.
6/17	10" - 350' Drlg. 1120'
6/24	Lans. 2290' Drlg. 2710'
7/1	Viola 3373' T.D. 3374' Run casing.
7/8	T.D. 3378' 1700' oil 3 hours.
	2000 acid.
7/15	Pump 123 oil in 8 hours.
7/22	7" @ 3370'
	Viola 3370'
	T.D. 3378'
	3500 Acid
	Pump 561 pot.
	Gravity 36.
	COMPLETED

Form 26 200 Bks. 5-41 McW. McPherson KANSAS

Map No. 42 Sec. 6 Twp. 17 R. 3W


Well No. 1 Carlson

J. E. Mabee Company

FIRST REPORT Contractor

C WL SW SE

SECTION PLAT

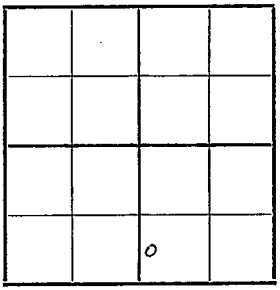

____ Ft. from N. Line

660 Ft. from S. Line

____ Ft. from E. Line

330 Ft. from W. Line

WILDCAT

Location

Rig up

Drilling and Remarks:

Derrick

RECORD

Cased ____ in., ____ ft.

Sand

Gas

Oil

Total Depth

PRODUCTION

1st 24 hrs. Nat.

1st 24 hrs. after shot

Gas ____ Cu. Ft.

Dry Hole

Abandoned

Date

JUN 10 1942 19

S. J. LEWIS Scout

Form 26 200 Bks. 5-41 McW. McPherson KANSAS

Map No. 42 Sec. 6 Twp. 17 R. 3W

Well No. 1 Carlson

J. E. Mabee Company

COMPLETED Contractor

C W L SW SE

Ft. from N. Line


660 Ft. from S. Line

Ft. from E. Line

330 Ft. from W. Line

WILDCAT

SECTION PLAT

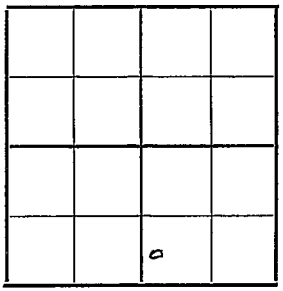

Location

Rig up

Drilling and Remarks:

Viola 3378

7" @ 3378

3500 Acid

Pump 5 bbls per hr

36° Gr

RECORD

Cased in., ft.

Sand

Gas

Oil

Total Depth 3378

PRODUCTION

1st 24 hrs. Nat.

1st 24 hrs. after shot

Gas Cu. Ft.

Dry Hole

Abandoned

Date

JUL 22 1942 19

S. J. LEWIS Scout