


McPherson

Section 6 Township 17 Range 3W

Well No. #2 Carlson

Company Mabee

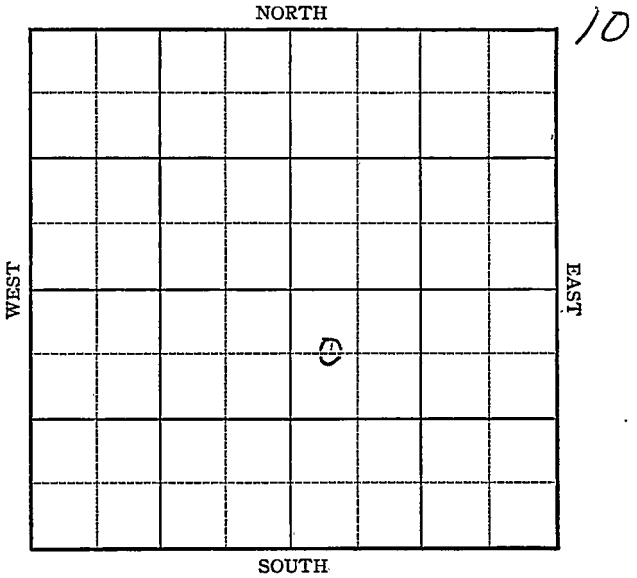

Sec. 6 Twp. 17 R. 3W

Well No. #2 Carlson Farm

Mabee Company

Lindsborg


660 Ft. from N. Line

\_\_\_\_\_ Ft. from S. Line

\_\_\_\_\_ Ft. from E. Line

330 Ft. from W. Line

*Elev. 1353*

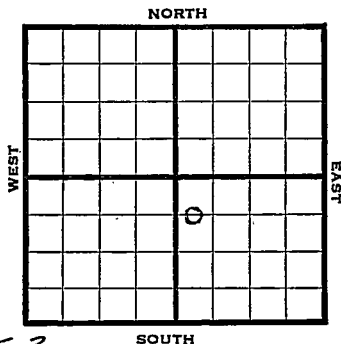

1944

REPORT

5/3

15" @ 165  
 10" @ 342  
 Viola 3378  
 5" @ 3381  
 TD 3382  
 RUST

5/10

"

5/17

"

5/24

"

5/31

5" @ 3379 corrected  
 500' acid 1500' oil & 200' wtr in 44 h

6/7

5" @ 3379'  
 Viola 3378  
 TD 3382  
 1500 acid  
 Pump 105 Pot.  
 Grav. 36.0

**COMPLETED**

KANSAS

Pool Name Lindsborg

Map No. 42 Sec. 6 Twp. 17 R. 3W

Well No. 2 Carlson

Mabee Company

**FIRST REPORT** Contractor

C W L NW SE

**SECTION PLAT**

660 Ft. from N. Line

\_\_\_\_\_ Ft. from S. Line

\_\_\_\_\_ Ft. from E. Line

330 Ft. from W. Line

		o	

McPherson County

Location \_\_\_\_\_

Rig up \_\_\_\_\_

Drilling and Remarks:

15" - 165

10" - 342

Viola 3378

5" - 3381

TD 3382 RUST

**RECORD**

Cased \_\_\_\_\_ in., \_\_\_\_\_ ft.

Sand \_\_\_\_\_

Gas \_\_\_\_\_

Oil \_\_\_\_\_

Total Depth \_\_\_\_\_

**PRODUCTION**

1st 24 hrs. Nat. \_\_\_\_\_

1st 24 hrs. after shot \_\_\_\_\_

Gas \_\_\_\_\_ Cu. Ft.

Dry Hole \_\_\_\_\_

Abandoned \_\_\_\_\_

Date

MAY 3 1944 19

S. J. LEWIS Scout

KANSAS

Pool Name Lindsborg

Map No. 42 Sec. 6 Twp. 17 R. 3W

Well No. 2 Carlson

Mabee Company

**COMPLETED** Contractor

C W L NW SE

SECTION FLAT

660 Ft. from N. Line

\_\_\_\_\_ Ft. from S. Line

\_\_\_\_\_ Ft. from E. Line

330 Ft. from W. Line

		o	
23			

McPherson County

Location \_\_\_\_\_

Rig up \_\_\_\_\_

Drilling and Remarks:

*Vida 3375*  
*5" @ 3379*  
*1500 acid*  
*Pump 105 P.D.*  
*360 Gr*

RECORD

Cased \_\_\_\_\_ in., \_\_\_\_\_ ft.

Sand \_\_\_\_\_

Gas \_\_\_\_\_

Oil \_\_\_\_\_

Total Depth 3382

PRODUCTION

1st 24 hrs. Nat. \_\_\_\_\_

1st 24 hrs. after shot \_\_\_\_\_

Gas \_\_\_\_\_ Cu. Ft.

Dry Hole \_\_\_\_\_

Abandoned \_\_\_\_\_

Date

JUN 7 1944 19

S. J. LEWIS Scout