

KANSAS


Ellsworth

FORM 51 5M 1-42 PETROL

Section 7 Township 17 Range 9-W

Well No. #1 Kootz

Company Lario Oil & Gas

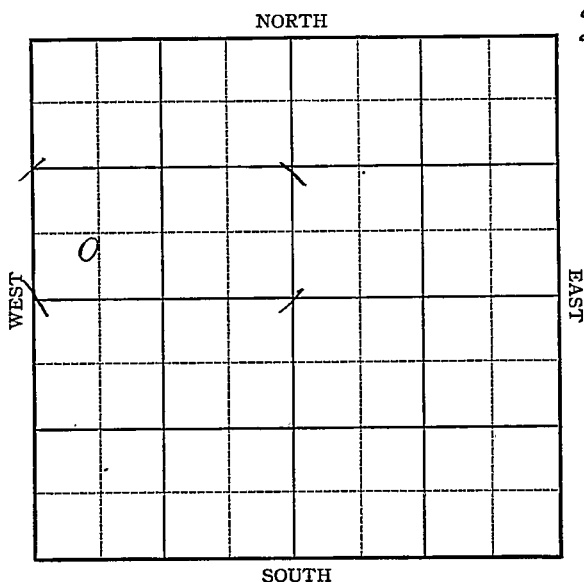

KANSAS

Sec. 7 Twp. 17 R. 9-W

Well No. #1 Kootz Farm

Lario Oil & Gas Company

Wildcat


 Ft. from N. Line

510 Ft. from S. Line

 Ft. from E. Line

510 Ft. from W. Line

Elev. 1791

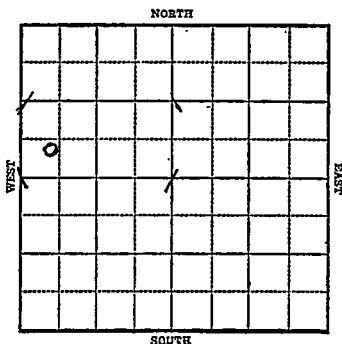

1943


R E P O R T

3/17 Location.
3/24 Surface hole.
3/31 Drlg. 1800
4/14 Arb. 3282
T.D. 3300'
No shows.

ABANDONED

KANSAS

Ellsworth

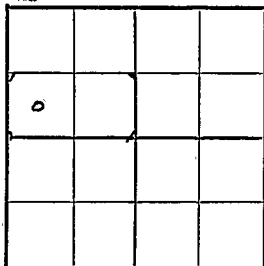Map No. 45 Sec. 7 Twp. 17 R. 9WWell No. 1 KootzLario Oil & Gas CompanyCORRECTION ContractorC SW NW **FIRST REPORT** SECTION PLAT Ft. from N. Line510 Ft. from S. Line Ft. from E. Line510 Ft. from W. Line

WILDCAT

Location Rig up

Drilling and Remarks:

Had spotted
wrong

RECORD

Cased in., ft.Sand Gas Oil Total Depth

PRODUCTION

1st 24 hrs. Nat. 1st 24 hrs. after shot Gas Cu. Ft.Dry Hole Abandoned

Date

MAR 17 1943 19

S. I. LEWIS Scout

Misc Small Maps *One*
Cards *Book*
Tracing *2775*
France Map *✓*
Scarborough Map *AS*
Moody Map *2775*
Geological Dept. _____
Moody Flat Book _____

KANSAS
Map No. 45 Sec. 7 Twp. 17 R. 9WWell No. 1 KootzLario Oil & Gas Company

ABANDONED

Contractor

C SW NW

SECTION PLAT

o			

 Ft. from N. Line510 Ft. from S. Line Ft. from E. Line510 Ft. from W. Line

WILDCAT

Location Rig up

Drilling and Remarks:


RECORD

Cased in., ft.Sand Gas Oil Total Depth 3300

PRODUCTION

1st 24 hrs. Nat. 1st 24 hrs. after shot Gas Cu. Ft.Dry Hole Abandoned

Date

APR 14 1943 19 S. J. LEWIS Scout

Misc Small Maps *Quat*

Cards *Beet*

Tracing *ms*

France Map *ms*

Scarborough Map *ms*

Moody Map *ms*

Geological Dist.

Moody Flat Book