KANSAS


Form 51—5M—4-36—Palace

Ellsworth

Section 7 Township 17 Range 10-W

Well Number #1-Andrea

Company Geo. Hinkle et al

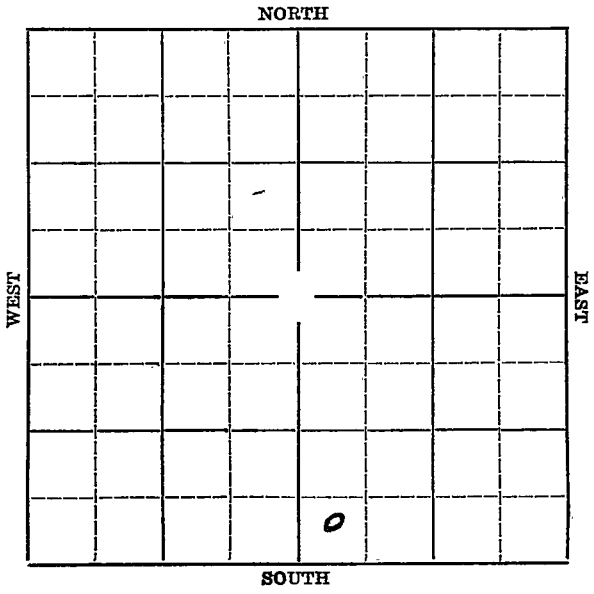


Form 252-A
5M 7-35 MPC

Ellsworth

Map No. KANSAS Sec. 7 Twp. 17 R. 10W

Well No. #1 Andrea Farm

Geo. Hinkle et al Company

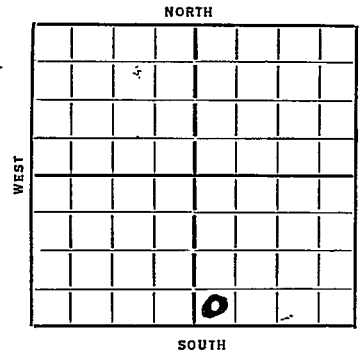

_____ Ft. from N. Line

330' Ft. from S. Line

_____ Ft. from E. Line

330' Ft. from W. Line

Elev. 1871

Date 1936	REPORT
8/5	Rig.
8/13	Rigging.
8/20	Rigging up.
8/27	15½" @ 380'. Drlg. 485'.
9/3	Anhydrate 630'. 12½" @ 636'. Drlg. 1320'.
9/10	10" @ 1822'. Drlg. 1878'.
9/18	10" @ 1852'. Drlg. 2130'.
9/24	10" @ 2180'. Drlg. 2456'.
10/1	Kansas City 2993'. Drlg. 3000'.
10/8	8" @ 3003'. Drlg. 3331'.
10/14/36	Sil. 3315'.
	T.D. 3365'.
	Hole full of water.
	Dry and abandoned.
	ABANDONED

Form 26 1M Blks. 7-29.

KANSAS


Map No. 55 Sec. 7 Twp. 17 R. 10W

Well No. 1 Andrea

Geo Kimble Et al Company

Contractor

SECTION PLAT

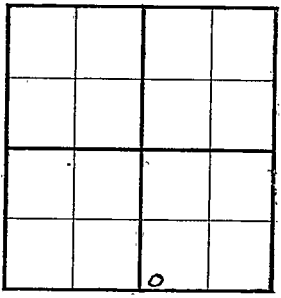

____ Ft. from N. Line

320 Ft. from S. Line

____ Ft. from E. Line

330 Ft. from W. Line

FIRST REPORT

Location

Rig up

Drilling and Remarks:

Rig

RECORD

Cased ____ in., ____ ft.

Sand

Gas

Oil

Total Depth

PRODUCTION

1st 24 hrs. Nat.

1st 24 hrs. after shot

Gas ____ Cu. Ft.

Dry Hole

Abandoned

Date

AUG 5 1936 19

S. J. LEWIS Scout

Form 26 1M Blks 4-3-29

KANSAS


Map No. 55 Sec. 7 Twp. 17 R. 10W

Well No. 1 Andrea

Kimble Company

Contractor

SECTION PLAT

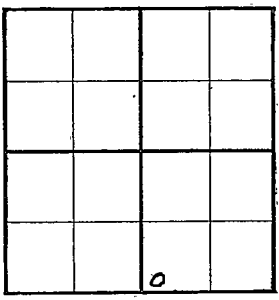

____ Ft. from N. Line

330 Ft. from S. Line

____ Ft. from E. Line

330 Ft. from W. Line

ABANDONED

Location ____

Rig up ____

Drilling and Remarks:

S.C. 3315

NFW

D & A

RECORD

Cased ____ in., ____ ft.

Sand ____

Gas ____

Oil ____

Total Depth 3365

PRODUCTION

1st 24 hrs. Nat. ____

1st 24 hrs. after shot ____

Gas ____ Cu. Ft.

Dry Hole ____

Abandoned ____

Date

OCT 14 1936 19

S. J. LEWIS Scout