Ellsworth

Form 51—5M—11-31—Palace

Map No. KANSAS Sec. 7 Twp. 17 R. 10 W

Well No. 7 Andrea Farm

Magnolia Company

NORTH

WEST

EAST

SOUTH

Location

Drilling Remarks

Rig Up

Drilling Remarks

RECORD

Cased in. ft.

Sand

Gas

Oil

Total Depth

PRODUCTION

1st 24 hrs. Nat.

1st 24 hrs. after shot

Gas cu. ft.

Dry Hole

Abandoned

Ellsworth

Form 252-A
5M 4-32 MPC

Map No. KANSAS Sec. 7 Twp 17 R. 10W

Well No. 2 Andrew Farm

Magnolia Company

330 Ft. from N. Line

Ft. from S. Line

Ft. from E. Line

990 Ft. from W. Line

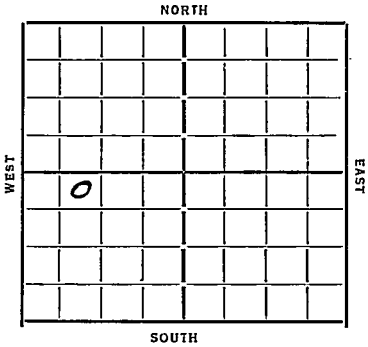

Date 1934	REPORT
5/23	Cellar
5/31	R.O.G.
6/7	Rig
6/14	Rig up
6/21	Spud
6/28	Dly 595 15" 418
7/5	" 970 15" 701
7/12	Show gas 1535 10" 1883
	Dly 2030
7/19	Dly 2430
7/26	" 2890
8/2	TKC 3026
8/9	TD 3124 Swab 2 Bbls oil
	per hr 1000 acid
8/15	Sand K.C.L. 3026
	T.D. 3124
	1000 acid 208 bbls
	oil
	COMPLETED

Form 26—1M Bks.—2-29

Ellsworth KANSAS

Map No. 55 Sec. 7 Twp. 17 R. 10W

Well No. 7- Andrea

Magnolia Company

Contractor

FIRST REPORTS

330 Ft. from N. Line

Ft. from S. Line

Ft. from E. Line

990 Ft. from W. Line

SECTION PLAT

Location

Rig up

Drilling and Remarks:

Cellar

RECORD

Cased in., ft.

Sand

Gas

Oil

Total Depth

PRODUCTION

1st 24 hrs. Nat.

1st 24 hrs. after shot

Gas Cu. Ft.

Dry Hole

Abandoned

Date 5-13-37 19

ORVAL MANNSCHRECK Scout

no work [illegible]

Re [illegible]
C [illegible]
Type [illegible]
Fr [illegible]
[illegible]
[illegible]
Sc [illegible]
[illegible]

Form 26—1M-Bks.—2-29

Ellsworth

Map No. 55 Sec. 7 Twp. 17 R. 10W

Well No. 2 - Andrea

Magnolia Company

Contractor

COMPLETED

SECTION PLAT

0			

330 Ft. from N. Line

Ft. from S. Line

Ft. from E. Line

990 Ft. from W. Line

Location

Rig up

Drilling and Remarks:

1000 acid

208 bbls

RECORD

Cased in. ft.

Sand K.C.L. 3026

Gas

Oil

Total Depth 3124

PRODUCTION

1st 24 hrs. Nat.

1st 24 hrs. after shot

Gas Cu. Ft.

Dry Hole

Abandoned

Date

8-15-37 19 ORVAL MANNSCHRECK Scout

no work

Returned
Cards
Tracing
France Map
Scarborough Map
Moody Map
Scarborough Plat Book
Moody Plat Book